


1 LOCATION OF WATER WELL: County: Shawnee Fraction: SE 1/4 SE 1/4 SE 1/4 Section Number: 15 Township Number: T 11 S Range Number: R 15 E

Distance and direction from nearest town or city street address of well if located within city? Hydro-flex Corp 2101 N.W. Brickyard Rd, Topeka, KS Well is located 675 ft North of hydro-flex on Brickyard Rd.

2 WATER WELL OWNER: KDHE  
 RR#, St. Address, Box # :  
 City, State, ZIP Code : Monitoring Well HF-1 (off-site) Board of Agriculture, Division of Water Resources  
 Application Number:

3 LOCATE WELL'S LOCATION WITH AN "X" IN SECTION BOX:

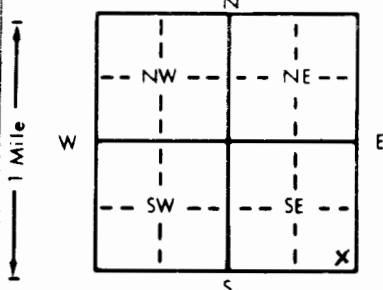

4 DEPTH OF COMPLETED WELL: 45.9 ft. ELEVATION:  
 Depth(s) Groundwater Encountered 1. 29 ft. 2. ft. 3. ft.  
 WELL'S STATIC WATER LEVEL: 27.8 ft. below land surface measured on mo/day/yr 3-12-87  
 Pump test data: Well water was ft. after hours pumping gpm  
 Est. Yield gpm: Well water was ft. after hours pumping gpm  
 Bore Hole Diameter: 8 in. to 47 ft., and in. to ft.  
 WELL WATER TO BE USED AS:  
 1 Domestic 3 Feedlot 5 Public water supply 6 Oil field water supply 8 Air conditioning 9 Dewatering 10 Observation well 11 Injection well 12 Other (Specify below)  
 2 Irrigation 4 Industrial 7 Lawn and garden only  
 Was a chemical bacteriological sample submitted to Department? Yes X No; If yes, mo/day/yr sample was submitted 1-23-87 Water Well Disinfected? Yes No X

5 TYPE OF BLANK CASING USED:  
 1 Steel 2 PVC 3 RMP (SR) 4 ABS 5 Wrought iron 6 Asbestos-Cement 7 Fiberglass 8 Concrete tile 9 Other (specify below) CASING JOINTS: Glued Clamped Welded Threaded

Blank casing diameter: 2 in. to 35.9 ft., Dia. in. to ft., Dia. in. to ft.  
 Casing height above land surface: 27.6 in., weight lbs./ft. Wall thickness or gauge No.

TYPE OF SCREEN OR PERFORATION MATERIAL:  
 1 Steel 2 Brass 3 Stainless steel 4 Galvanized steel 5 Fiberglass 6 Concrete tile 7 PVC 8 RMP (SR) 9 ABS 10 Asbestos-cement 11 Other (specify) 12 None used (open hole)

SCREEN OR PERFORATION OPENINGS ARE:  
 1 Continuous slot 2 Louvered shutter 3 Mill slot 4 Key punched 5 Gauzed wrapped 6 Wire wrapped 7 Torch cut 8 Saw cut 9 Drilled holes 10 Other (specify) 11 None (open hole)

SCREEN-PERFORATED INTERVALS: From 35.9 ft. to 45.9 ft., From ft. to ft.  
 GRAVEL PACK INTERVALS: From 12 ft. to 45.9 ft., From ft. to ft.  
 From ft. to ft., From ft. to ft.

6 GROUT MATERIAL: 1 Neat cement 2 Cement grout 3 Bentonite 4 Other  
 Grout Intervals: From 0 ft. to 10 ft., From 10 ft. to 12 ft., From ft. to ft.

What is the nearest source of possible contamination:  
 1 Septic tank 2 Sewer lines 3 Watertight sewer lines 4 Lateral lines 5 Cess pool 6 Seepage pit 7 Pit privy 8 Sewage lagoon 9 Feedyard 10 Livestock pens 11 Fuel storage 12 Fertilizer storage 13 Insecticide storage 14 Abandoned water well 15 Oil well/Gas well 16 Other (specify below)

Direction from well? How many feet?

FROM	TO	LITHOLOGIC LOG	FROM	TO	LITHOLOGIC LOG
0	2	Topsoil and Chat			
2	8	Silt, Clayey, VFL-VFU, DK. Brown			
8	27	Silt, Sandy, FL-FU, Yellow Brown			
27	47	Sand, FU-CL, Partly Sorted, Yellow Brown			

7 CONTRACTOR'S OR LANDOWNER'S CERTIFICATION: This water well was (1) constructed, (2) reconstructed, or (3) plugged under my jurisdiction and was completed on (mo/day/year) 11-27-86 and this record is true to the best of my knowledge and belief. Kansas Water Well Contractor's License No. This Water Well Record was completed on (mo/day/yr) 3-13-87 under the business name of KDHE by (signature) Debra Agapito