


1 LOCATION OF WATER WELL: Fraction SW 1/4 SE 1/4 SE 1/4 Section Number X 16 Township Number T 11 S Range Number R 15 EW
 County: SHAWNEE
 Distance and direction from nearest town or city street address of well if located within city?
1 N of Topeka

2 WATER WELL OWNER: Jim Munger
 RR#, St. Address, Box #: 2138 NW Menoken Road Board of Agriculture, Division of Water Resources
 City, State, ZIP Code: Topeka, KS 66618 Application Number:

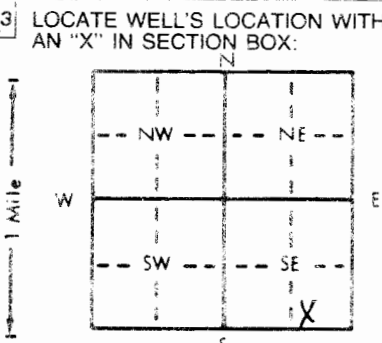

4 DEPTH OF COMPLETED WELL: 55' ft. ELEVATION:
 Depth(s) Groundwater Encountered: 40 ft. 2 ft. 3 ft. 4 ft.
 WELL'S STATIC WATER LEVEL: 34 ft. below land surface measured on mo/day/yr 6-24-88
 Pump test data: Well water was ft. after hours pumping gpm
 Est. Yield: 50 gpm; Well water was ft. after hours pumping gpm
 Bore Hole Diameter: 12" in. to ft., and in. to ft.
 WELL WATER TO BE USED AS:
 1 Domestic 3 Feedlot 6 Oil field water supply 9 Dewatering 12 Other (Specify below)
 2 Irrigation 4 Industrial 7 Lawn and garden only 10 Monitoring well
 Was a chemical/bacteriological sample submitted to Department? Yes No X ; if yes, mo/day/yr sample was submitted
 Water Well Disinfected? Yes X No

5 TYPE OF BLANK CASING USED:
 1 Steel 3 RMP (SR) 6 Asbestos-Cement 9 Other (specify below) Welded
 2 PVC 4 ABS 7 Fiberglass Threaded
 Blank casing diameter: 5" in. Dia. 0-45 ft. Dia. in. to ft. Dia. in. to ft.
 Casing height above land surface: 24" in., weight: 2.82 lbs./ft. Wall thickness or gauge No. .258
 TYPE OF SCREEN OR PERFORATION MATERIAL:
 1 Steel 3 Stainless steel 5 Fiberglass 8 RMP (SR) 10 Asbestos-cement
 2 Brass 4 Galvanized steel 6 Concrete tile 9 ABS 11 Other (specify)
 12 None used (open hole)
 SCREEN OR PERFORATION OPENINGS ARE:
 1 Continuous slot 3 Mill slot 6 Wire wrapped 9 Drilled holes
 2 Louvered shutter 4 Key punched 7 Torch cut 10 Other (specify)
 SCREEN-PERFORATED INTERVALS: From: 45 ft. to 55 ft. From ft. to ft.
 From: ft. to ft. From ft. to ft.
 GRAVEL PACK INTERVALS: From: 24 ft. to 55 ft. From ft. to ft.
 From: ft. to ft. From ft. to ft.

6 GROUT MATERIAL: 1 Neat cement 2 Cement grout 3 Bentonite 4 Other
 Grout Intervals: From: 4 ft. to 24 ft. From ft. to ft. From ft. to ft.
 What is the nearest source of possible contamination:
 1 Septic tank 4 Lateral lines 7 Pit privy 10 Livestock pens 14 Abandoned water well
 2 Sewer lines 5 Cess pool 8 Sewage lagoon 11 Fuel storage 15 Oil well/Gas well
 3 Watertight sewer lines 6 Seepage pit 9 Feedyard 12 Fertilizer storage 16 Other (specify below)
 13 Insecticide storage
 Direction from well? NW How many feet? 110

FROM	TO	LITHOLOGIC LOG	FROM	TO	PLUGGING INTERVALS
0	5	Top Soil			
5	38	Clay-Brown-Silty			
38	42	Fine Sand-Coarse Sand-Brown			
42	55	Fine Sand-Coarse Sand-Med-Pea Gravel-Brown			
55		Green			

7 CONTRACTOR'S OR LANDOWNER'S CERTIFICATION: This water well was (1) constructed, (2) reconstructed, or (3) plugged under my jurisdiction and was completed on (mo/day/year) 6-24-88 and this record is true to the best of my knowledge and belief. Kansas Water Well Contractor's License No. 182. This Water Well Record was completed on (mo/day/yr) 7-27-88 under the business name of Strader Drilling Co., Inc. by (signature) [Signature]