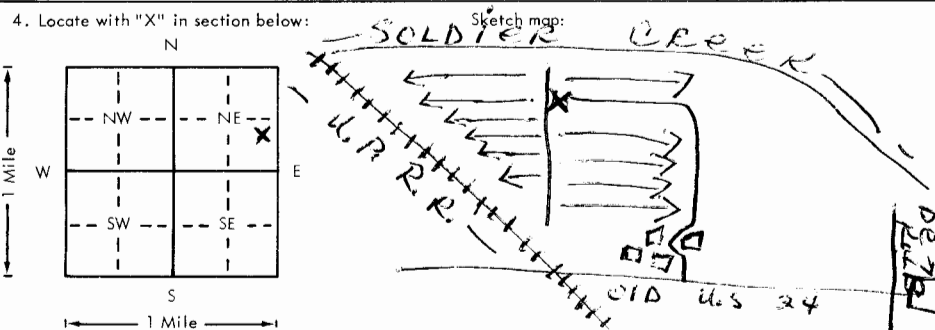


USE TYPEWRITER OR BALL POINT PEN—PRESS FIRMLY, PRINT CLEARLY.

WATER WELL RECORD  
KSA 82a-1201-1215

Kansas Department of Health and Environment—Division of Environment  
(Water well Contractors)  
Topeka, Kansas 66620

1. Location of well: County: <b>Shawnee</b>		Fraction: <b>NE 1/4 SE 1/4 NE 1/4</b>		Section number: <b>17</b>		Township number: <b>T 11S</b>		Range number: <b>S R 15E</b>		E/W: <b>E/W</b>	
2. Distance and direction from nearest town or city: <b>5 mi. East of Silver Lake, Ks. &amp; 1/2 mi. North.</b> Street address of well location if in city:				3. Owner of well: <b>Aloys Schwermann</b> R.R. or street: <b>R. R. # 6</b> City, state, zip code: <b>Topeka, Kansas 66608</b>							
4. Locate with "X" in section below: 				6. Bore hole dia. <b>30</b> in. Completion date <b>11-7-77</b> Well depth <b>56</b> ft.				7. <input type="checkbox"/> Cable tool <input type="checkbox"/> Rotary <input type="checkbox"/> Driven <input type="checkbox"/> Dug <input type="checkbox"/> Hollow rod <input type="checkbox"/> Jetted <input type="checkbox"/> Bored <input checked="" type="checkbox"/> Reverse rotary			
5. Type and color of material				8. Use: <input type="checkbox"/> Domestic <input type="checkbox"/> Public supply <input type="checkbox"/> Industry <input checked="" type="checkbox"/> Irrigation <input type="checkbox"/> Air conditioning <input type="checkbox"/> Stock <input type="checkbox"/> Lawn <input type="checkbox"/> Oil field water <input type="checkbox"/> Other				9. Casing: Material <b>Trans.</b> Height <input checked="" type="checkbox"/> Above br below Threaded <input type="checkbox"/> Welded <input type="checkbox"/> Surface <b>12</b> in. RMP <input type="checkbox"/> PVC <input type="checkbox"/> Weight <input type="checkbox"/> lbs./ft. Dia. <b>16</b> in. to <b>30</b> ft. depth Wall Thickness: inches or Dia. <input type="checkbox"/> in. to <input type="checkbox"/> ft. depth gage No. <b>.75"</b>			
				10. Screen: Manufacturer's name <b>Johnson Well Casing Co.</b> Type <b>Transite</b> Dia. <b>16"</b> Slot/gauze <b>1/8 x 8</b> Length <b>26'</b> Set between <b>30</b> ft. and <b>56</b> ft. Gravel pack? <input checked="" type="checkbox"/> <b>yes</b> Size range of material <b>1/8-1/4"</b>				11. Static water level: <input type="checkbox"/> mo./day/yr. <b>23</b> ft. below land surface Date <b>11-7-77</b>			
Dark brown gumbo				From				To			
Fine brown sandy clay				0				21			
Med. brown gravel & sandy clay				21				24			
Small to medium brown gravel				24				25			
Med. to large brown gravel				25				39			
Med. to large green gravel				39				43			
Med. green gravel & gray clay				43				48			
Med. to large green gravel				48				50			
Brown shale-stopped.				50				56			
								12. Pumping level below land surfaces: <b>36</b> ft. after <b>1</b> hrs. pumping <b>300</b> g.p.m. <b>43</b> ft. after <b>3</b> hrs. pumping <b>1000</b> g.p.m. Estimated maximum yield <b>1000</b> g.p.m.			
								13. Water sample submitted: <input type="checkbox"/> Yes <input checked="" type="checkbox"/> No Date _____			
								14. Well head completion: <input type="checkbox"/> Pitless adapter _____ Inches above grade			
								15. Well grouted? <input checked="" type="checkbox"/> <b>yes</b> With: <input type="checkbox"/> Neat cement <input type="checkbox"/> Bentonite <input checked="" type="checkbox"/> Concrete Depth: From <b>0</b> ft. to <b>10</b> ft.			
								16. Nearest source of possible contamination: <b>Soldier</b> ft. <b>800</b> Direction <b>north</b> Type <b>Creek</b> Well disinfected upon completion? <input type="checkbox"/> Yes <input checked="" type="checkbox"/> No			
								17. Pump: <input checked="" type="checkbox"/> <b>X</b> Not installed Manufacturer's name _____ Model number _____ HP _____ Volts _____ Length of drop pipe _____ ft. capacity _____ g.p.m. Type: <input type="checkbox"/> Submersible <input type="checkbox"/> Turbine <input type="checkbox"/> Jet <input type="checkbox"/> Reciprocating <input type="checkbox"/> Centrifugal <input type="checkbox"/> Other			
								20. Water well contractor's certification: This well was drilled under my jurisdiction and this report is true to the best of my knowledge and belief. <b>Hoobler Drilling Co.</b> <b>323</b> Business name License No. Address <b>St. Marys, Ks. 66536</b> Signed <b>[Signature]</b> Date <b>11-30</b> Authorized Representative			
18. Elevation: _____		19. Remarks: <b>This is a redrilled well.</b> <b>old well next to well about 10 feet away casing has hole in it</b>									

11 150 17 NE 514