

USE TYPEWRITER OR BALL POINT PEN-PRESS FIRMLY, PRINT CLEARLY.

WATER WELL RECORD  
KSA 82a-1201-1215

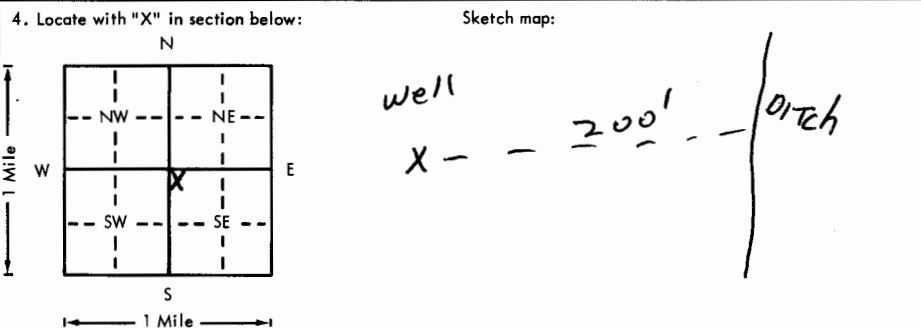
Kansas Department of Health and Environment-Division of Environment (Water well Contractors)  
Topeka, Kansas 66620

NW DAB

chf loc. jd

1. Location of well: County Shawnee Fraction NE 1/4 NW 1/4 SE 1/4 Section number 22 Township number T 11 S Range number R 15 EW

2. Distance and direction from nearest town or city: 3 E .7 S 3. Owner of well: DICK SKINNER  
Street address of well location if in city: OF HAWK KIRO R.R. or street:  
City, state, zip code: TOPEKA,

4. Locate with "X" in section below: Sketch map:  


5. Type and color of material

	From	To
<u>SAND</u>	<u>0</u>	<u>17</u>
<u>FINE SAND - COURSE SAND</u>	<u>17</u>	<u>28</u>
<u>COURSE SAND - PEA GR.</u>	<u>28</u>	<u>30</u>
<u>CLAY, BLUE</u>	<u>30</u>	<u>33</u>
<u>COURSE SAND - med. GR - PEA GR.</u>	<u>33</u>	<u>46</u>

6. Bore hole dia. 24 in. Completion date 3-11-77  
Well depth 46 ft.

7.  Cable tool  Rotary  Driven  Dug  
 Hollow rod  Jetted  Bored  Reverse rotary

8. Use:  Domestic  Public supply  Industry  
 Irrigation  Air conditioning  Stock  
 Lawn  Oil field water  Other

9. Casing: Material Steel Height: Above or below  
Threaded  Welded  Surface 24 in.  
RMP  PVC  Weight 8.42 lbs./ft.  
Dia. 16 in. to 46 ft. depth; Wall Thickness: inches or  
Dia.     in. to     ft. depth; gage No. 250

10. Screen: Manufacturer's name DOERR  
Type Steel Dia. 16  
Sift/gauze 100 Length 12  
Set between 34 ft. and 46 ft.  
Gravel pack?  Size range of material 14/20

11. Static water level: 22 ft. below land surface Date 3-11-77 mo./day/yr.

12. Pumping level below land surfaces:  
    ft. after     hrs. pumping     g.p.m.  
    ft. after     hrs. pumping     g.p.m.  
Estimated maximum yield 700 g.p.m.

13. Water sample submitted:     mo./day/yr.  
Yes  No  Date    

14. Well head completion: CAP  
    Pitless adapter 24 inches above grade

15. Well grouted?   
With:  Neat cement  Bentonite  Concrete  
Depth: From 0 ft. to 20 ft.

16. Nearest source of possible contamination:  
ft. 300 Direction E Type DRAINAGE  
Well disinfected upon completion?  Yes  No

17. Pump:  Not installed  
Manufacturer's name      
Model number     HP     Volts      
Length of drop pipe     ft. capacity     g.p.m.  
Type:  
 Submersible  Turbine  
 Jet  Reciprocating  
 Centrifugal  Other

18. Elevation: ~883  
Topography:  Hill  Slope  Upland  Valley

19. Remarks: OWNER WILL INSTAL BASE

20. Water well contractor's certification:  
This well was drilled under my jurisdiction and this report is true to the best of my knowledge and belief.  
Steedee Dalg Co Inc 182  
Business name RTI Halton, KS License No.      
Address      
Signed Dale Bohan Date 3-11-77  
Authorized representative

11 250 22 NW NE SE  
T  
R  
Sec