

310

Silver Lake

chop
jd

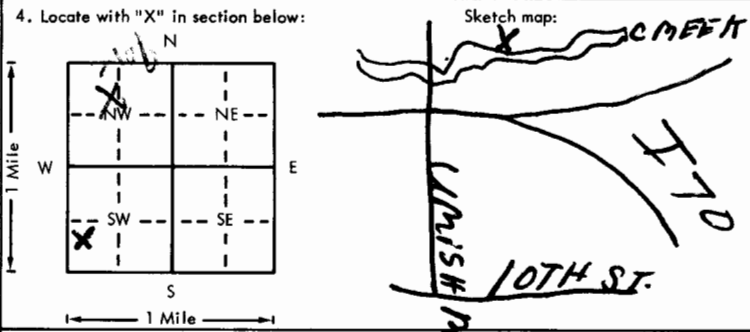
USE TYPEWRITER OR BALL POINT PEN-PRESS FIRMLY, PRINT CLEARLY.

See map

WATER WELL RECORD
KSA 82a-1201-1215

Kansas Department of Health and Environment-Division of Environment
(Water well Contractors)
Topeka, Kansas 66620

SW NWNW ^{BBC}
BAB

1. Location of well: County: SHAWNEE		Fraction: NE NW NW 1/4 1/4		Section number: 32		Township number: T 14S		Range number: S R 15 E E/W																		
2. Distance and direction from nearest town or city: 1 MILE WEST OF TOPEKA				3. Owner of well: KANS. STATE HISTORICAL SOCIETY R.R. or street: PRITANOMIE BAPTIST MISSION SITE NORTH OF E-70 GRISH ROAD City, state, zip code: TOPEKA KANS 66612																						
4. Locate with "X" in section below: 				5. Type and color of material		6. Bore hole dia. 5 in. Completion date 9-78 Well depth 37 ft.		7. <input checked="" type="checkbox"/> Cable tool <input type="checkbox"/> Rotary <input type="checkbox"/> Driven <input type="checkbox"/> Dug <input type="checkbox"/> Hollow rod <input type="checkbox"/> Jetted <input type="checkbox"/> Bored <input type="checkbox"/> Reverse rotary		8. Use: <input type="checkbox"/> Domestic <input type="checkbox"/> Public supply <input checked="" type="checkbox"/> Industry <input type="checkbox"/> Irrigation <input type="checkbox"/> Air conditioning <input type="checkbox"/> Stock <input type="checkbox"/> Lawn <input type="checkbox"/> Oil field water <input type="checkbox"/> Other																
<table border="1"> <thead> <tr> <th></th> <th>From</th> <th>To</th> </tr> </thead> <tbody> <tr> <td>Soil</td> <td>0</td> <td>2</td> </tr> <tr> <td>YELLOW CLAY</td> <td>2</td> <td>10</td> </tr> <tr> <td>MUDDY BLUE CLAY</td> <td>10</td> <td>17</td> </tr> <tr> <td>MUDDY CLAY WITH LAYERS OF SAND</td> <td>17</td> <td>37</td> </tr> <tr> <td><u>BED ROCK</u> - ?</td> <td>37</td> <td></td> </tr> </tbody> </table>						From	To	Soil	0	2	YELLOW CLAY	2	10	MUDDY BLUE CLAY	10	17	MUDDY CLAY WITH LAYERS OF SAND	17	37	<u>BED ROCK</u> - ?	37		9. Casing: Material _____ Height: Above or below _____ Threaded _____ Welded _____ Surface 36 in. RMP <input checked="" type="checkbox"/> PVC _____ Weight _____ lbs./ft. Dia. 5 in. to 37 ft. depth Wall Thickness: inches or _____ Dia. _____ in. to _____ ft. depth gage No. 200		10. Screen: Manufacturer's name PERFORATED STAY-IN-PLACE Type _____ Dia. 5 1/2 " Slot/gauze 3/16 " Length 20 Set between 17 ft. and 37 ft. Set between _____ ft. and _____ ft. Gravel pack? <input checked="" type="checkbox"/> Size range of material 1/4"	
						From	To																			
					Soil	0	2																			
					YELLOW CLAY	2	10																			
					MUDDY BLUE CLAY	10	17																			
					MUDDY CLAY WITH LAYERS OF SAND	17	37																			
<u>BED ROCK</u> - ?	37																									
11. Static water level: _____ mo./day/yr. 12 ft. below land surface Date SEP 16, 78		12. Pumping level below land surfaces: 35 ft. after 4 hrs. pumping 19 g.p.m. _____ ft. after _____ hrs. pumping _____ g.p.m. Estimated maximum yield 19 g.p.m.		13. Water sample submitted: _____ mo./day/yr. <input checked="" type="checkbox"/> Yes <input type="checkbox"/> No Date _____		14. Well head completion: _____ Pitless adapter _____ inches above grade		15. Well grouted? _____ With: <input checked="" type="checkbox"/> Neat cement <input type="checkbox"/> Bentonite <input type="checkbox"/> Concrete Depth: From 0 ft. to 16 ft.		16. Nearest source of possible contamination: _____ ft. _____ Direction S Type CASEN Well disinfected upon completion? <input checked="" type="checkbox"/> Yes <input type="checkbox"/> No																
17. Pump: <input checked="" type="checkbox"/> Not installed Manufacturer's name _____ Model number _____ HP _____ Volts _____ Length of drop pipe _____ ft. capacity _____ g.p.m. Type: <input type="checkbox"/> Submersible <input type="checkbox"/> Turbine <input type="checkbox"/> Jet <input type="checkbox"/> Reciprocating <input type="checkbox"/> Centrifugal <input type="checkbox"/> Other		18. Elevation: 900 RM Topography: <input type="checkbox"/> Hill <input type="checkbox"/> Slope <input type="checkbox"/> Upland <input checked="" type="checkbox"/> Valley		19. Remarks: WE RECOMMEND WATER NOT BE USED FOR HUMAN CONSUMPTION ONLY FOR LAVATORY STUOL AND YARD ALSO RECOMMEND WATER BE CHLORINATED AFTER PUMPS INSTALLED WELL SHOULD HAVE 4'x4'x4" CONCRETE PAD AROUND WELL (Use a second sheet if needed)		20. Water well contractor's certification: This well was drilled under my jurisdiction and this report is true to the best of my knowledge and belief. JUNGMANN BROS DRILLING 119 Business name _____ License No. _____ Address CARBONDALE KS 66414 Signed Jungmann Bros Date 9-24-78 Authorized representative																				



T 14S
R 15E
S 32
NW 32