


1 LOCATION OF WATER WELL: County: Shawnee Fraction: NW 1/4 NW 1/4 SW 1/4 Section Number: 33 Township Number: T 11 S Range Number: R 15 EW

Distance and direction from nearest town or city street address of well if located within city?
300' south of the southeast corner of 10th and Wanamaker in Topeka, KS

2 WATER WELL OWNER: Kansas Imperial, Inc. MW-3
 RR#, St. Address, Box #: 1601 SW. 37th
 City, State, ZIP Code: Topeka, KS 66611
 Board of Agriculture, Division of Water Resources
 Application Number:

3 LOCATE WELL'S LOCATION WITH AN "X" IN SECTION BOX:

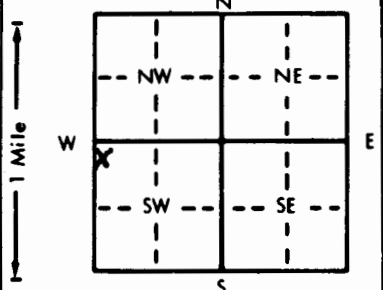

4 DEPTH OF COMPLETED WELL: 20 ft. ELEVATION:

Depth(s) Groundwater Encountered 1. 8 ft. 2. 8 ft. 3. 8 ft.

WELL'S STATIC WATER LEVEL: 8 ft. below land surface measured on mo/day/yr 4-17-89

Pump test data: Well water was _____ ft. after _____ hours pumping _____ gpm

Est. Yield _____ gpm: Well water was _____ ft. after _____ hours pumping _____ gpm

Bore Hole Diameter: 8 in. to _____ ft., and _____ in. to _____ ft.

WELL WATER TO BE USED AS: 5 Public water supply 8 Air conditioning 11 Injection well

1 Domestic 3 Feedlot 6 Oil field water supply 9 Dewatering 12 Other (Specify below)

2 Irrigation 4 Industrial 7 Lawn and garden only 10 Monitoring well

Was a chemical/bacteriological sample submitted to Department? Yes _____ No X; If yes, mo/day/yr sample was submitted

Water Well Disinfected? Yes _____ No X

5 TYPE OF BLANK CASING USED: 1 Steel 3 RMP (SR) 5 Wrought iron 8 Concrete tile CASING JOINTS: Glued _____ Clamped _____

2 PVC 4 ABS 7 Fiberglass _____ Welded _____ Threaded X

Blank casing diameter _____ in. to 5 ft., Dia _____ in. to _____ ft., Dia _____ in. to _____ ft.

Casing height above land surface 2 in., weight _____ lbs./ft. Wall thickness or gauge No. Sch. 40

TYPE OF SCREEN OR PERFORATION MATERIAL: 1 Steel 3 Stainless steel 5 Fiberglass 7 PVC 10 Asbestos-cement

2 Brass 4 Galvanized steel 6 Concrete tile 9 ABS 11 Other (specify) _____

SCREEN OR PERFORATION OPENINGS ARE: 5 Gauzed wrapped 8 Saw cut 11 None (open hole)

1 Continuous slot 3 Mill slot 6 Wire wrapped 9 Drilled holes

2 Louvered shutter 4 Key punched 7 Torch cut 10 Other (specify) _____

SCREEN-PERFORATED INTERVALS: From 5 ft. to 20 ft., From _____ ft. to _____ ft.

GRAVEL PACK INTERVALS: From 4 ft. to 20 ft., From _____ ft. to _____ ft.

6 GROUT MATERIAL: 1 Neat cement 2 Cement grout 3 Bentonite 4 Other _____

Grout Intervals: From surface ft. to 4 ft., From _____ ft. to _____ ft.

What is the nearest source of possible contamination: 10 Livestock pens 14 Abandoned water well

1 Septic tank 4 Lateral lines 7 Pit privy 1 Fuel storage abundant 15 Oil well/Gas well

2 Sewer lines 5 Cess pool 8 Sewage lagoon 12 Fertilizer storage 16 Other (specify below)

3 Watertight sewer lines 6 Seepage pit 9 Feedyard 13 Insecticide storage

Direction from well? West How many feet? 15

FROM	TO	LITHOLOGIC LOG	FROM	TO	PLUGGING INTERVALS
0	5	Brown, silky CLAY			
5	20	Gray, silky CLAY			
Grout variance and casing height variance for flush mount covers granted					

7 CONTRACTOR'S OR LANDOWNER'S CERTIFICATION: This water well was (1) constructed (2) reconstructed, or (3) plugged under my jurisdiction and was completed on (mo/day/year) 4-17-89 and this record is true to the best of my knowledge and belief. Kansas

Water Well Contractor's License No. 494 This Water Well Record was completed on (mo/day/yr) 5/19/89

under the business name of Crownwater Testing Co by (signature) [Signature]