


1 LOCATION OF WATER WELL: County: Shawnee Fraction: NW 1/4 NW 1/4 SW 1/4 Section Number: 33 Township Number: T 11 S Range Number: R 15 E/W

Distance and direction from nearest town or city street address of well if located within city?
300' south of the southeast corner of 10th and Wauwaker Topeka KS

2 WATER WELL OWNER: Kansas Imperial, Inc. MW-2
 RR#, St. Address, Box #: 1601 S.W. 37th
 City, State, ZIP Code: Topeka, KS 66611
 Board of Agriculture, Division of Water Resources
 Application Number:

3 LOCATE WELL'S LOCATION WITH AN "X" IN SECTION BOX:

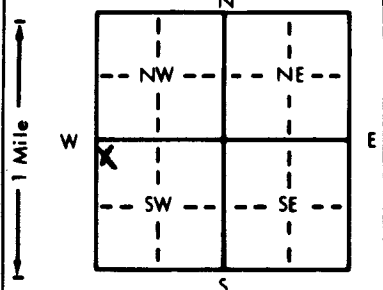

4 DEPTH OF COMPLETED WELL: 22 ft. ELEVATION:

Depth(s) Groundwater Encountered 1. 8 ft. 2. . ft. 3. . ft.
 WELL'S STATIC WATER LEVEL: 8 ft. below land surface measured on mo/day/yr 4-17-89
 Pump test data: Well water was . ft. after . hours pumping . gpm
 Est. Yield . gpm: Well water was . ft. after . hours pumping . gpm
 Bore Hole Diameter: 8 in. to 23 ft., and . in. to . ft.
 WELL WATER TO BE USED AS:
 5 Public water supply 8 Air conditioning 11 Injection well
 1 Domestic 3 Feedlot 6 Oil field water supply 9 Dewatering 12 Other (Specify below)
 2 Irrigation 4 Industrial 7 Lawn and garden only 10 Monitoring well
 Was a chemical/bacteriological sample submitted to Department? Yes . No X; If yes, mo/day/yr sample was submitted
 Water Well Disinfected? Yes . No X

5 TYPE OF BLANK CASING USED:
 1 Steel 3 RMP (SR) 5 Wrought iron 8 Concrete tile CASING JOINTS: Glued . Clamped .
2 PVC 4 ABS 6 Asbestos-Cement 9 Other (specify below) Welded .
 7 Fiberglass Threaded. X

Blank casing diameter: 3 in. to 6 ft., Dia . in. to . ft., Dia . in. to . ft.
 Casing height above land surface: 2 in., weight . lbs./ft. Wall thickness or gauge No. 5.440

TYPE OF SCREEN OR PERFORATION MATERIAL:
 1 Steel 3 Stainless steel 5 Fiberglass 8 RMP (SR) 10 Asbestos-cement
 2 Brass 4 Galvanized steel 6 Concrete tile 9 ABS 11 Other (specify) .
 12 None used (open hole)

SCREEN OR PERFORATION OPENINGS ARE:
 1 Continuous slot 3 Mill slot 5 Gauzed wrapped 8 Saw cut 11 None (open hole)
 2 Louvered shutter 4 Key punched 6 Wire wrapped 9 Drilled holes
 7 Torch cut 10 Other (specify) .

SCREEN-PERFORATED INTERVALS: From 6 ft. to 22 ft., From . ft. to . ft.
 From . ft. to . ft., From . ft. to . ft.
 GRAVEL PACK INTERVALS: From 5 ft. to 22 ft., From . ft. to . ft.
 From . ft. to . ft., From . ft. to . ft.

6 GROUT MATERIAL: 1 Neat cement 2 Cement grout 3 Bentonite 4 Other .

Grout intervals: From surface ft. to 5 ft., From . ft. to . ft., From . ft. to . ft.
 What is the nearest source of possible contamination:
 1 Septic tank 4 Lateral lines 7 Pit privy 11 Fuel storage abundant 14 Abandoned water well
 2 Sewer lines 5 Cess pool 8 Sewage lagoon 12 Fertilizer storage 15 Oil well/Gas well
 3 Watertight sewer lines 6 Seepage pit 9 Feedyard 13 Insecticide storage 16 Other (specify below)

Direction from well? East How many feet? 50

FROM	TO	LITHOLOGIC LOG	FROM	TO	PLUGGING INTERVALS
0	9	brown, Silky CLAY			
9	23	Gray, Silky CLAY			
<p><i>Grout variance and casing height variance for flush mount covers grouted.</i></p>					

7 CONTRACTOR'S OR LANDOWNER'S CERTIFICATION: This water well was (1) constructed (2) reconstructed, or (3) plugged under my jurisdiction and was completed on (mo/day/year) 4-17-89 and this record is true to the best of my knowledge and belief. Kansas Water Well Contractor's License No. 496 This Water Well Record was completed on (mo/day/yr) 5/19/89 under the business name of Groundwater Technicians by (signature) David Land