


1 LOCATION OF WATER WELL: Fraction SE 1/4 SE 1/4 SW 1/4 Section Number 35 Township Number T 11 S Range Number R 15 EW
 County: SHAWNEE

Distance and direction from nearest town or city street address of well if located within city?
N. of HUNTOON - W. of OKLEY STS - TOPEKA

2 WATER WELL OWNER: MRS. CALVIN MONKES
 RR#, St. Address, Box #: 3100 HUNTOON Board of Agriculture, Division of Water Resources
 City, State, ZIP Code: TOPEKA KS 66605 Application Number:

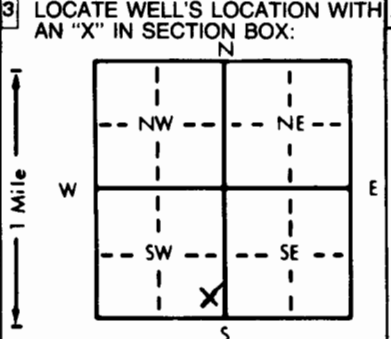

4 DEPTH OF COMPLETED WELL: 20 ft. ELEVATION:
 Depth(s) Groundwater Encountered 1. 15 ft. 2. --- ft. 3. --- ft.
 WELL'S STATIC WATER LEVEL 15 ft. below land surface measured on mo/day/yr
 Pump test data: Well water was --- ft. after --- hours pumping --- gpm
 Est. Yield --- gpm: Well water was --- ft. after --- hours pumping --- gpm
 Bore Hole Diameter: 8.625 in. to 20 ft., and --- in. to --- ft.
 WELL WATER TO BE USED AS: 5 Public water supply 8 Air conditioning 11 Injection well
 1 Domestic 3 Feedlot 6 Oil field water supply 9 Dewatering 12 Other (Specify below)
 2 Irrigation 4 Industrial 7 Lawn and garden only 10 Monitoring well
 Was a chemical/bacteriological sample submitted to Department? Yes --- No X; If yes, mo/day/yr sample was submitted
 Water Well Disinfected? Yes --- No X

5 TYPE OF BLANK CASING USED: 5 Wrought iron 8 Concrete tile CASING JOINTS: Glued --- Clamped ---
 1 Steel 3 RMP (SR) 6 Asbestos-Cement 9 Other (specify below) Welded ---
2 PVC 4 ABS 7 Fiberglass Threaded X
 Blank casing diameter 2 in. to 9.3 ft., Dia. --- in. to --- ft., Dia. --- in. to --- ft.
 Casing height above land surface: FLUSH 0 in., weight SCH 40 lbs./ft. Wall thickness or gauge No. ---
 TYPE OF SCREEN OR PERFORATION MATERIAL: 7 PVC 10 Asbestos-cement
 1 Steel 3 Stainless steel 5 Fiberglass 8 RMP (SR) 11 Other (specify) ---
 2 Brass 4 Galvanized steel 6 Concrete tile 9 ABS 12 None used (open hole)
 SCREEN OR PERFORATION OPENINGS ARE: 5 Gauzed wrapped 8 Saw cut 11 None (open hole)
 1 Continuous slot 3 Mill slot 6 Wire wrapped 9 Drilled holes
 2 Louvered shutter 4 Key punched 7 Torch cut 10 Other (specify) ---
 SCREEN-PERFORATED INTERVALS: From 9.3 ft. to 19.5 ft., From --- ft. to --- ft.
SAND From --- ft. to --- ft., From --- ft. to --- ft.
~~GRAVEL~~ PACK INTERVALS: From 8.3 ft. to 20 ft., From --- ft. to --- ft.
 From --- ft. to --- ft., From --- ft. to --- ft.

6 GROUT MATERIAL: 1 Neat cement 2 Cement grout 3 Bentonite 4 Other ---
 Grout Intervals: From 6L ft. to 6.3 ft., From 6.3 ft. to 8.3 ft., From --- ft. to --- ft.
 What is the nearest source of possible contamination:
 1 Septic tank 4 Lateral lines 7 Pit privy 10 Livestock pens 14 Abandoned water well
 2 Sewer lines 5 Cess pool 8 Sewage lagoon 11 Fuel storage 15 Oil well/Gas well
 3 Watertight sewer lines 6 Seepage pit 9 Feedyard 12 Fertilizer storage 16 Other (specify below)
CONTAMINATED SITE
 Direction from well? --- How many feet? ---

FROM	TO	LITHOLOGIC LOG	FROM	TO	PLUGGING INTERVALS
<u>6L</u>	<u>0.75</u>	<u>ASPHALT - CONCRETE</u>			
<u>0.75</u>	<u>5</u>	<u>SILTY CLAY</u>			
<u>5</u>	<u>11.8</u>	<u>CLAY SILT WITH SD + P. GRAVEL</u>			
<u>11.8</u>	<u>12.2</u>	<u>LIME STONE</u>			
<u>12.2</u>	<u>15</u>	<u>CLAY SILT</u>			
<u>15</u>	<u>20</u>	<u>SHALE</u>			
<u>TD</u>	<u>20</u>				

7 CONTRACTOR'S OR LANDOWNER'S CERTIFICATION: This water well was (1) constructed, (2) reconstructed, or (3) plugged under my jurisdiction and was completed on (mo/day/year) 05-19-94 and this record is true to the best of my knowledge and belief. Kansas Water Well Contractor's License No. 479 This Water Well Record was completed on (mo/day/yr) 05-20-94 under the business name of EBBERTS DRILLING by (signature) [Signature]

OFFICE USE ONLY
T
R
EW
SEC