


MW-5  
Range Number  
R 15

1 LOCATION OF WATER WELL: County: Shawnee Fraction: SW 1/4 SW 1/4 SE 1/4 Section Number: 35 Township Number: T 11 S Range Number: R 15

Distance and direction from nearest town or city street address of well if located within city?  
1244 Oakley, Topeka

2 WATER WELL OWNER: Ann Rolley Trust Attn: Allan Rolley  
RR#, St. Address, Box #: P.O. Box 5228  
City, State, ZIP Code: Topeka, KS 66605  
Board of Agriculture, Division of Water Resources  
Application Number:

3 LOCATE WELL'S LOCATION WITH AN "X" IN SECTION BOX:

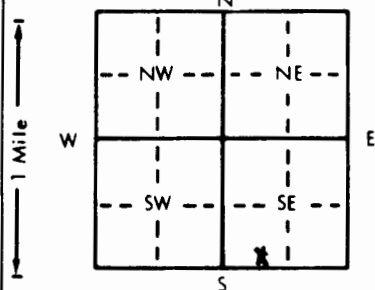

4 DEPTH OF COMPLETED WELL: 15.0 ft. ELEVATION:

Depth(s) Groundwater Encountered 1. 8.6 ft. 2. — ft. 3. — ft.  
WELL'S STATIC WATER LEVEL: 9.21 ft. below land surface measured on mo/day/yr 6/6/94  
Pump test data: Well water was — ft. after — hours pumping — gpm  
Est. Yield — gpm; Well water was — ft. after — hours pumping — gpm  
Bore Hole Diameter: 8.625 in. to 15.0 ft., and — in. to — ft.  
WELL WATER TO BE USED AS:  
5 Public water supply 8 Air conditioning 11 Injection well  
1 Domestic 3 Feedlot 6 Oil field water supply 9 Dewatering 12 Other (Specify below)  
2 Irrigation 4 Industrial 7 Lawn and garden only 10 Monitoring well  
Was a chemical/bacteriological sample submitted to Department? Yes — No X; If yes, mo/day/yr sample was submitted —  
Water Well Disinfected? Yes — No X

5 TYPE OF BLANK CASING USED:  
1 Steel 3 RMP (SR) 5 Wrought iron 8 Concrete tile CASING JOINTS: Glued — Clamped —  
2 PVC 4 ABS 6 Asbestos-Cement 9 Other (specify below) Welded —  
Blank casing diameter 2 in. to 5 ft. Dia. — in. to — ft. Dia. — in. to — ft.  
Casing height above land surface 30 in., weight sch 40 lbs./ft. Wall thickness or gauge No. —  
TYPE OF SCREEN OR PERFORATION MATERIAL:  
1 Steel 3 Stainless steel 5 Fiberglass 7 PVC 10 Asbestos-cement  
2 Brass 4 Galvanized steel 6 Concrete tile 8 RMP (SR) 11 Other (specify) —  
SCREEN OR PERFORATION OPENINGS ARE:  
1 Continuous slot 3 Mill slot 5 Gauzed wrapped 8 Saw cut 11 None (open hole)  
2 Louvered shutter 4 Key punched 6 Wire wrapped 9 Drilled holes  
7 Torch cut 10 Other (specify) —

SCREEN-PERFORATED INTERVALS: From 5 ft. to 15 ft. From — ft. to — ft.  
From — ft. to — ft. From — ft. to — ft.  
From — ft. to — ft. From — ft. to — ft.

SAND GRAVEL PACK INTERVALS: From 4 ft. to 15 ft. From — ft. to — ft.  
From — ft. to — ft. From — ft. to — ft.

6 GROUT MATERIAL: 1 Neat cement 2 Cement grout 3 Bentonite 4 Other —  
Grout Intervals: From 2 ft. to 2 ft. From 2 ft. to 4 ft. From — ft. to — ft.  
What is the nearest source of possible contamination:  
1 Septic tank 4 Lateral lines 7 Pit privy 10 Livestock pens 14 Abandoned water well  
2 Sewer lines 5 Cess pool 8 Sewage lagoon 11 Fuel storage 15 Oil well/Gas well  
3 Watertight sewer lines 6 Seepage pit 9 Feedyard 12 Fertilizer storage 16 Other (specify below) contaminated site  
13 Insecticide storage

Direction from well? — How many feet? —

FROM	TO	LITHOLOGIC LOG	FROM	TO	PLUGGING INTERVALS
<u>GL</u>	<u>1</u>	<u>Soil</u>			
<u>1</u>	<u>6.5</u>	<u>Clayey silt, brown, firm</u>			
<u>6.5</u>	<u>15.0</u>	<u>Siltstone, tan to green gray hydrocarbon odor</u>			
<u>TD</u>	<u>15.0</u>	<u>Saturated lease @ 8.6</u>			

7 CONTRACTOR'S OR LANDOWNER'S CERTIFICATION: This water well was (1) constructed, (2) reconstructed, or (3) plugged under my jurisdiction and was completed on (mo/day/year) 05-31-94 and this record is true to the best of my knowledge and belief. Kansas Water Well Contractor's License No. 479 This Water Well Record was completed on (mo/day/yr) 06-22-94 under the business name of EBBERTS DRILLING by (signature) Alvin Ebberts