


1 LOCATION OF WATER WELL: Fraction SE 1/4 SE 1/4 SW 1/4 Section Number 35 Township Number T 11 S Range Number R 15 EW
 County: SHAWNEE

Distance and direction from nearest town or city street address of well if located within city?
N of HUNTOON - W of OAKLEY ST. TOPEKA

2 WATER WELL OWNER: MRS CALVIN MONKES
 RR#, St. Address, Box #: 3100 HUNTOON Board of Agriculture, Division of Water Resources
 City, State, ZIP Code: TOPEKA, KS 66605 Application Number:

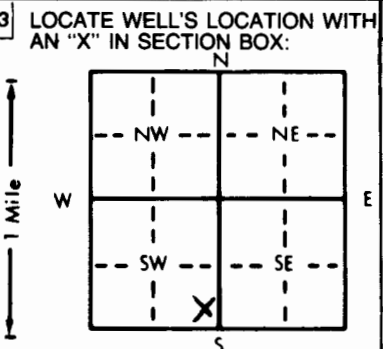

4 DEPTH OF COMPLETED WELL: 18 ft. ELEVATION: _____
 Depth(s) Groundwater Encountered 1. 11.4 ft. 2. _____ ft. 3. _____ ft.
 WELL'S STATIC WATER LEVEL 11.4 ft. below land surface measured on mo/day/yr _____
 Pump test data: Well water was _____ ft. after _____ hours pumping _____ gpm
 Est. Yield _____ gpm: Well water was _____ ft. after _____ hours pumping _____ gpm
 Bore Hole Diameter: 9.625 in. to 18 ft., and _____ in. to _____ ft.
 WELL WATER TO BE USED AS:
 5 Public water supply 8 Air conditioning 11 Injection well
 1 Domestic 3 Feedlot 6 Oil field water supply 9 Dewatering 12 Other (Specify below)
 2 Irrigation 4 Industrial 7 Lawn and garden only 10 Monitoring well
 Was a chemical/bacteriological sample submitted to Department? Yes _____ No X; If yes, mo/day/yr sample was submitted _____
 Water Well Disinfected? Yes _____ No X

5 TYPE OF BLANK CASING USED:
 1 Steel 3 RMP (SR) 5 Wrought iron 8 Concrete tile CASING JOINTS: Glued _____ Clamped _____
 2 PVC 4 ABS 6 Asbestos-Cement 9 Other (specify below) Welded _____
 7 Fiberglass Threaded X
 Blank casing diameter 2 in. to 7.5 ft., Dia _____ in. to _____ ft., Dia _____ in. to _____ ft.
 Casing height above land surface FLUSH in., weight SCH 40 lbs./ft. Wall thickness or gauge No. _____
 TYPE OF SCREEN OR PERFORATION MATERIAL:
 1 Steel 3 Stainless steel 5 Fiberglass 7 PVC 10 Asbestos-cement
 2 Brass 4 Galvanized steel 6 Concrete tile 8 RMP (SR) 11 Other (specify) _____
 9 ABS 12 None used (open hole)
 SCREEN OR PERFORATION OPENINGS ARE:
 1 Continuous slot 3 Mill slot 5 Gauzed wrapped 8 Saw cut 11 None (open hole)
 2 Louvered shutter 4 Key punched 6 Wire wrapped 9 Drilled holes
 7 Torch cut 10 Other (specify) _____
 SCREEN-PERFORATED INTERVALS: From 7.5 ft. to 17.5 ft., From _____ ft. to _____ ft.
 From _____ ft. to _____ ft., From _____ ft. to _____ ft.
~~GRAVEL~~ SAND PACK INTERVALS: From 6.6 ft. to 18 ft., From _____ ft. to _____ ft.
 From _____ ft. to _____ ft., From _____ ft. to _____ ft.

6 GROUT MATERIAL: 1 Neat cement 2 Cement grout 3 Bentonite 4 Other _____
 Grout Intervals: From GL ft. to 4.6 ft., From 4.6 ft. to 6.6 ft., From _____ ft. to _____ ft.
 What is the nearest source of possible contamination:
 1 Septic tank 4 Lateral lines 7 Pit privy 10 Livestock pens 14 Abandoned water well
 2 Sewer lines 5 Cess pool 8 Sewage lagoon 11 Fuel storage 15 Oil well/Gas well
 3 Watertight sewer lines 6 Seepage pit 9 Feedyard 12 Fertilizer storage 16 Other (specify below) CONTAMINATED SITE
 13 Insecticide storage
 Direction from well? _____ How many feet? _____

FROM	TO	LITHOLOGIC LOG	FROM	TO	PLUGGING INTERVALS
<u>GL</u>	<u>1.5</u>	<u>ASPHALT AND LS. GRAVEL</u>			
<u>1.5</u>	<u>3</u>	<u>SILTY CLAY</u>			
<u>3</u>	<u>5</u>	<u>CLAY SILT WITH COARSE SAND</u>			
<u>5</u>	<u>11.4</u>	<u>CLAY SILT</u>			
<u>11.4</u>	<u>11.4</u>	<u>SAND LENSE</u>			
<u>11.4</u>	<u>13</u>	<u>CLAY SILT</u>			
<u>13</u>	<u>18</u>	<u>SHALE</u>			
<u>TD</u>	<u>18</u>				

7 CONTRACTOR'S OR LANDOWNER'S CERTIFICATION: This water well was (1) constructed, (2) reconstructed, or (3) plugged under my jurisdiction and was completed on (mo/day/year) 05-19-94 and this record is true to the best of my knowledge and belief. Kansas Water Well Contractor's License No. 479 This Water Well Record was completed on (mo/day/yr) 05-20-94 under the business name of EBBERTS DRILLING by (signature) Gregor Ebberts

OFFICE USE ONLY

T

R

FW

SEC.

1/4

1/4

1/4