


MAJ-6

1 LOCATION OF WATER WELL: Fraction SW 1/4 SW 1/4 SE 1/4 Section Number 35 Township Number T 11 S Range Number R 15
 County: Shawnee

Distance and direction from nearest town or city street address of well if located within city?
25 Feet NE of 1244 Oakley in Alley

2 WATER WELL OWNER: City of Topeka Development/Coordination Office
 RR#, St. Address, Box #: 515 S. Kansas Ave, Rm 402 ATTN: Greg Schell
 City, State, ZIP Code: Topeka, KS 66603
 Board of Agriculture, Division of Water Resources
 Application Number:

3 LOCATE WELL'S LOCATION WITH AN "X" IN SECTION BOX:

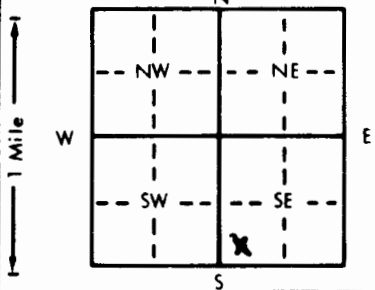

4 DEPTH OF COMPLETED WELL: 15 ft. ELEVATION:
 Depth(s) Groundwater Encountered 1. 8.9 ft. 2. — ft. 3. — ft.
 WELL'S STATIC WATER LEVEL: 9.83 ft. below land surface measured on mo/day/yr 6/6/94

Pump test data: Well water was — ft. after — hours pumping — gpm
 Est. Yield — gpm: Well water was — ft. after — hours pumping — gpm
 Bore Hole Diameter: 8.625 in. to 15 ft., and — in. to — ft.
 WELL WATER TO BE USED AS:
 5 Public water supply 8 Air conditioning 11 Injection well
 1 Domestic 3 Feedlot 6 Oil field water supply 9 Dewatering 12 Other (Specify below)
 2 Irrigation 4 Industrial 7 Lawn and garden only 10 Monitoring well
 Was a chemical/bacteriological sample submitted to Department? Yes — No X; If yes, mo/day/yr sample was submitted —
 Water Well Disinfected? Yes — No X

5 TYPE OF BLANK CASING USED:
 1 Steel 3 RMP (SR) 5 Wrought iron 8 Concrete tile CASING JOINTS: Glued — Clamped —
 2 PVC 4 ABS 6 Asbestos-Cement 9 Other (specify below) Welded —
 7 Fiberglass Threaded X

Blank casing diameter: 4.2 in. to 4.8 ft., Dia — in. to — ft., Dia — in. to — ft.
 Casing height above land surface: Flush mount in., weight Sch 40 lbs./ft. Wall thickness or gauge No. —

TYPE OF SCREEN OR PERFORATION MATERIAL:
 1 Steel 3 Stainless steel 5 Fiberglass 7 PVC 10 Asbestos-cement
 2 Brass 4 Galvanized steel 6 Concrete tile 8 RMP (SR) 11 Other (specify) —
 12 None used (open hole)

SCREEN OR PERFORATION OPENINGS ARE:
 1 Continuous slot 3 Mill slot 5 Gauzed wrapped 8 Saw cut 11 None (open hole)
 2 Louvered shutter 4 Key punched 6 Wire wrapped 9 Drilled holes
 7 Torch cut 10 Other (specify) —

SCREEN-PERFORATED INTERVALS: From 4.8 ft. to 14.8 ft., From — ft. to — ft., From — ft. to — ft.
 From — ft. to — ft., From — ft. to — ft., From — ft. to — ft.
Sand PACK INTERVALS: From 3.8 ft. to 15 ft., From — ft. to — ft., From — ft. to — ft.

6 GROUT MATERIAL: 1 Neat cement 2 Cement grout 3 Bentonite 4 Other —
 Grout Intervals: From 2.0 ft. to 1.8 ft., From 1.8 ft. to 3.2 ft., From — ft. to — ft.

What is the nearest source of possible contamination:
 1 Septic tank 4 Lateral lines 7 Pit privy 10 Livestock pens 14 Abandoned water well
 2 Sewer lines 5 Cess pool 8 Sewage lagoon 11 Fuel storage 15 Oil well/Gas well
 3 Watertight sewer lines 6 Seepage pit 9 Feedyard 12 Fertilizer storage 16 Other (specify below) Contaminated Site
 Direction from well? SW How many feet? 25

FROM	TO	LITHOLOGIC LOG	FROM	TO	PLUGGING INTERVALS
<u>0.5</u>	<u>0.5</u>	<u>Soil</u>			
<u>0.5</u>	<u>3.5</u>	<u>Silty Clay, gray, stiff</u>			
<u>3.5</u>	<u>6.5</u>	<u>Clayey Silt, brown, stiff</u>			
<u>6.5</u>	<u>15</u>	<u>Siltstone, orange brn, sat. lens 0.8-9</u>			
<u>15</u>	<u>15</u>				

7 CONTRACTOR'S OR LANDOWNER'S CERTIFICATION: This water well was (1) constructed, (2) reconstructed, or (3) plugged under my jurisdiction and was completed on (mo/day/year) 06-01-94 and this record is true to the best of my knowledge and belief. Kansas Water Well Contractor's License No. 479 This Water Well Record was completed on (mo/day/yr) 06-22-94 under the business name of EBBERTS DRILLING by (signature) Greg Schell