


1 LOCATION OF WATER WELL: Fraction NE 1/4 SW 1/4 SW 1/4 Section Number 31 Township Number T 11 @ Range Number R 15 @
 County: Shawnee

Distance and direction from nearest town or city street address of well if located within city?
2.2 miles west of the 10th Wrensmaker Intersection on 10th South and near Hills Rd.

2 WATER WELL OWNER: Indian Hills Landfill (OW-02)
 RR#, St. Address, Box #: 1900 SW Indian Hills Rd
 City, State, ZIP Code: Topeka Ks
 Board of Agriculture, Division of Water Resources
 Application Number:

3 LOCATE WELL'S LOCATION WITH AN "X" IN SECTION BOX:

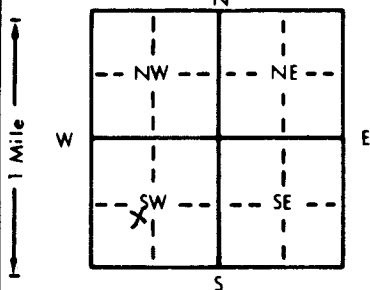

4 DEPTH OF COMPLETED WELL: 51.5 ft. ELEVATION: 1026.34
 Depth(s) Groundwater Encountered 1. 11.5 ft. 2. — ft. 3. — ft.
 WELL'S STATIC WATER LEVEL 11.5 ft. below land surface measured on mo/day/yr

Pump test data: Well water was — ft. after — hours pumping — gpm
 Est. Yield — gpm: Well water was — ft. after — hours pumping — gpm
 Bore Hole Diameter: 5.718 in. to 51.5 ft. and — in. to — ft.
 WELL WATER TO BE USED AS:
 1 Domestic 3 Feedlot 5 Public water supply 8 Air conditioning 11 Injection well
 2 Irrigation 4 Industrial 6 Oil field water supply 9 Dewatering 12 Other (Specify below)
 7 Lawn and garden only @ Monitoring well
 Was a chemical/bacteriological sample submitted to Department? Yes — No X; If yes, mo/day/yr sample was submitted
 Water Well Disinfected? Yes — No X

5 TYPE OF BLANK CASING USED:
 1 Steel 3 RMP (SR) 5 Wrought iron 8 Concrete tile CASING JOINTS: Glued — Clamped —
 @ PVC 4 ABS 7 Fiberglass Threaded X
 Blank casing diameter 2 in. to 46.0 ft. Dia — in. to — ft. Dia — in. to — ft.
 Casing height above land surface 30 in., weight Sch 40 lbs./ft. Wall thickness or gauge No. —

TYPE OF SCREEN OR PERFORATION MATERIAL:
 1 Steel 3 Stainless steel 5 Fiberglass 8 RMP (SR) 10 Asbestos-cement
 2 Brass 4 Galvanized steel 6 Concrete tile 9 ABS 11 Other (specify) —
 12 None used (open hole)

SCREEN OR PERFORATION OPENINGS ARE:
 1 Continuous slot @ Mill slot 5 Gauzed wrapped 8 Saw cut 11 None (open hole)
 2 Louvered shutter 4 Key punched 6 Wire wrapped 9 Drilled holes
 7 Torch cut 10 Other (specify) —

SCREEN-PERFORATED INTERVALS: From 46.0 ft. to 51.0 ft., From — ft. to — ft.
 From — ft. to — ft., From — ft. to — ft.
 GRAVEL PACK INTERVALS: From 41.75 ft. to 51.5 ft., From — ft. to — ft.
 From — ft. to — ft., From — ft. to — ft.

6 GROUT MATERIAL: 1 Neat cement @ Cement grout @ Bentonite 4 Other —
 Grout Intervals: From 0-0 ft. to 7.0 ft., From 7.0 ft. to 38.2 ft., From 38.2 ft. to 41.75 ft.

What is the nearest source of possible contamination:
 1 Septic tank 4 Lateral lines 7 Pit privy 10 Livestock pens 14 Abandoned water well
 2 Sewer lines 5 Cess pool 8 Sewage lagoon 11 Fuel storage 15 Oil well/Gas well
 3 Watertight sewer lines 6 Seepage pit 9 Feedyard 12 Fertilizer storage @ Other (specify below) Landfill
 13 Insecticide storage

Direction from well? _____ How many feet? _____

FROM	TO	LITHOLOGIC LOG	FROM	TO	PLUGGING INTERVALS
0.0	1.0	Lcl w/ trash DK Br			
1.0	3.0	Topsoil DK Gr			
3.0	8.0	F-cl Rd Br			
8.0	10.0	wea shale Gr			
10.0	21.5	L/S Gr			
21.5	26.0	Siltstone			
26.0	34.0	Sandstone Gr			
34.0	45.0	Si shaley Sandstone			
45.0	46.0	ys			
46.0	50.0	ss sh Gr			
50.0	51.5	coal BLK.			

7 CONTRACTOR'S OR LANDOWNER'S CERTIFICATION: This water well was (1) constructed, (2) reconstructed, or (3) plugged under my jurisdiction and was completed on (mo/day/year) 10/14/94 and this record is true to the best of my knowledge and belief. Kansas Water Well Contractor's License No. 416 This Water Well Record was completed on (mo/day/yr) 11/23/94
 under the business name of Terracon Consultants Inc by (signature) Richard D. ...