


1 LOCATION OF WATER WELL: Fraction hw 1/4 SW 1/4 SW 1/4 Section Number 31 Township Number T 11 S Range Number R 15 E
 County: Shawnee

Distance and direction from nearest town or city street address of well if located within city?
2.2 miles west of 10th Wanamaker 1/2 miles south Indian Hills Rd

2 WATER WELL OWNER: Indian Hills Landfill (OW-07)
 RR#, St. Address, Box #: 1200 SW Indian Hills Rd
 City, State, ZIP Code: Topeka KS
 Board of Agriculture, Division of Water Resources
 Application Number:

3 LOCATE WELL'S LOCATION WITH AN "X" IN SECTION BOX:

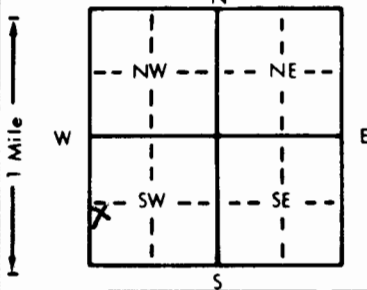

4 DEPTH OF COMPLETED WELL: 31.5 ft. ELEVATION: 999.9
 Depth(s) Groundwater Encountered 1. 30.0 ft. 2. — ft. 3. — ft.
 WELL'S STATIC WATER LEVEL 24.6 ft. below land surface measured on 10/12/94
 Pump test data: Well water was — ft. after — hours pumping — gpm
 Est. Yield — gpm: Well water was — ft. after — hours pumping — gpm
 Bore Hole Diameter: 5.78 in. to 25.531.5 ft., and — in. to — ft.

WELL WATER TO BE USED AS:
 5 Public water supply 8 Air conditioning 11 Injection well
 1 Domestic 3 Feedlot 6 Oil field water supply 9 Dewatering 12 Other (Specify below)
 2 Irrigation 4 Industrial 7 Lawn and garden only Monitoring well
 Was a chemical/bacteriological sample submitted to Department? Yes — No If yes, mo/day/yr sample was submitted
 Water Well Disinfected? Yes — No

5 TYPE OF BLANK CASING USED:
 1 Steel 3 RMP (SR) 5 Wrought iron 8 Concrete tile CASING JOINTS: Glued — Clamped —
 PVC 4 ABS 6 Asbestos-Cement 9 Other (specify below) Welded —
 7 Fiberglass Threaded

Blank casing diameter 2 in. to 25.9 ft., Dia — in. to — ft., Dia — in. to — ft.
 Casing height above land surface 30 in., weight Sch 40 lbs./ft. Wall thickness or gauge No. —

TYPE OF SCREEN OR PERFORATION MATERIAL:
 PVC 10 Asbestos-cement
 1 Steel 3 Stainless steel 5 Fiberglass 8 RMP (SR) 11 Other (specify) —
 2 Brass 4 Galvanized steel 6 Concrete tile 9 ABS 12 None used (open hole)

SCREEN OR PERFORATION OPENINGS ARE:
 1 Continuous slot Mill slot 5 Gauzed wrapped 8 Saw cut 11 None (open hole)
 2 Louvered shutter 4 Key punched 6 Wire wrapped 9 Drilled holes
 7 Torch cut 10 Other (specify) —

SCREEN-PERFORATED INTERVALS: From 25.9 ft. to 30.9 ft., From — ft. to — ft., From — ft. to — ft.
 GRAVEL PACK INTERVALS: From 21.4 ft. to 31.5 ft., From — ft. to — ft., From — ft. to — ft.

6 GROUT MATERIAL: 1 Neat cement 2 Cement grout Bentonite 4 Other —
 Grout Intervals: From 0.0 ft. to 16.8 ft., From 16.8 ft. to 21.4 ft., From — ft. to — ft.

What is the nearest source of possible contamination:
 1 Septic tank 4 Lateral lines 7 Pit privy 11 Fuel storage 14 Abandoned water well
 2 Sewer lines 5 Cess pool 8 Sewage lagoon 12 Fertilizer storage 15 Oil well/Gas well
 3 Watertight sewer lines 6 Seepage pit 9 Feedyard 13 Insecticide storage Other (specify below) Landfill

Direction from well? How many feet?

FROM	TO	LITHOLOGIC LOG	FROM	TO	PLUGGING INTERVALS
0.0	5.5	h/s spoils			
5.5	13.6	h/s + clay spoils			
13.6	17.0	l-cl Br-Gr-Br			
17.0	28.0	siltstone			
28.0	28.7	h/s			
28.7	30.0	claystone Gr			
30.0	31.0	Coal Blk			
31.0	31.5	clay stone Gr.			

7 CONTRACTOR'S OR LANDOWNER'S CERTIFICATION: This water well was constructed, (2) reconstructed, or (3) plugged under my jurisdiction and was completed on (mo/day/year) 10/12/94 and this record is true to the best of my knowledge and belief. Kansas Water Well Contractor's License No. 416 This Water Well Record was completed on (mo/day/yr) 11/28/94 under the business name of Terracon Consultants Inc by (signature) Richard D. ...