


1 LOCATION OF WATER WELL: County: Shawnee Fraction: SW 1/4 SE 1/4 SW 1/4 Section Number: 31 Township Number: T 11 S Range Number: R 15 E

Distance and direction from nearest town or city street address of well if located within city?
2.2 miles west of 10th Wanamaker 1 1/2 mile south on Indian Hills Rd

2 WATER WELL OWNER: Indian Hills Land Inc (OW-08)
 RR#, St. Address, Box #: 1900 SW Indian Hills Rd
 City, State, ZIP Code: Topeka, KS
 Board of Agriculture, Division of Water Resources
 Application Number:

3 LOCATE WELL'S LOCATION WITH AN "X" IN SECTION BOX:

4 DEPTH OF COMPLETED WELL: 44 ft. ELEVATION: 1018.07

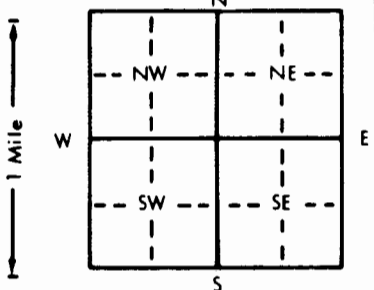

Depth(s) Groundwater Encountered: 1. — ft. 2. — ft. 3. — ft.
 WELL'S STATIC WATER LEVEL: 999 ft. below land surface measured on mo/day/yr
 Pump test data: Well water was — ft. after — hours pumping — gpm
 Est. Yield — gpm: Well water was — ft. after — hours pumping — gpm
 Bore Hole Diameter: 5 7/8 in. to 4 1/2 in. and — in. to — in.
 WELL WATER TO BE USED AS:
 1 Domestic 3 Feedlot 5 Public water supply 8 Air conditioning 11 Injection well
 2 Irrigation 4 Industrial 6 Oil field water supply 9 Dewatering 12 Other (Specify below)
 7 Lawn and garden only Monitoring well
 Was a chemical/bacteriological sample submitted to Department? Yes — No If yes, mo/day/yr sample was submitted
 Water Well Disinfected? Yes — No

5 TYPE OF BLANK CASING USED:
 1 Steel 3 RMP (SR) 5 Wrought iron 8 Concrete tile CASING JOINTS: Glued — Clamped —
 2 PVC 4 ABS 6 Asbestos-Cement 9 Other (specify below) Welded —
 7 Fiberglass Threaded
 Blank casing diameter: 8 1/2 in. to 38.5 ft., Dia — in. to — ft., Dia — in. to — ft.
 Casing height above land surface: 30 in., weight Sch 40 lbs./ft. Wall thickness or gauge No. —

TYPE OF SCREEN OR PERFORATION MATERIAL:
 1 Steel 3 Stainless steel 5 Fiberglass 8 RMP (SR) 10 Asbestos-cement 11 Other (specify)
 2 Brass 4 Galvanized steel 6 Concrete tile 9 ABS 12 None used (open hole)

SCREEN OR PERFORATION OPENINGS ARE:
 1 Continuous slot Mill slot 5 Gauzed wrapped 8 Saw cut 11 None (open hole)
 2 Louvered shutter 4 Key punched 6 Wire wrapped 9 Drilled holes
 7 Torch cut 10 Other (specify)

SCREEN-PERFORATED INTERVALS: From 38.5 ft. to 43.5 ft., From — ft. to — ft.
 From — ft. to — ft., From — ft. to — ft.
 GRAVEL PACK INTERVALS: From 34.0 ft. to 44.0 ft., From — ft. to — ft.
 From — ft. to — ft., From — ft. to — ft.

6 GROUT MATERIAL: 1 Neat cement 2 Cement grout 3 Bentonite 4 Other
 Grout Intervals: From 0-0 ft. to 32.0 ft., From 32.0 ft. to 34.0 ft., From — ft. to — ft.

What is the nearest source of possible contamination:
 1 Septic tank 4 Lateral lines 7 Pit privy 10 Livestock pens 14 Abandoned water well
 2 Sewer lines 5 Cess pool 8 Sewage lagoon 11 Fuel storage 15 Oil well/Gas well
 3 Watertight sewer lines 6 Seepage pit 9 Feedyard 12 Fertilizer storage Other (specify below)
Land fill

Direction from well? How many feet?

FROM	TO	LITHOLOGIC LOG	FROM	TO	PLUGGING INTERVALS
0.0	5.0	L-cl O1 Br - DK Gr.			
5.0	11.0	L-cl DK Gr.			
11.0	12.0	4s Gr			
12.0	12.4	Claystone Lt O1 Gr			
12.4	15.0	Siltstone Lt O1 Gr			
15.0	22.0	Sa siltstone Lt Gr - Lt Blue Gr			
22.0	22.4	Claystone silty DK Gr.			
22.4	31.4	Silty sandstone Lt Gr.			
31.4	33.0	Claystone silty DK Gr.			
33.0	41.0	Claystone DK Gr - Gr Blk			
41.0	41.5	4s DK Gr.			
41.5	43.0	Claystone DK Gr			
43.0	43.5	Coal			
43.5	44.0	Claystone Gr.			

7 CONTRACTOR'S OR LANDOWNER'S CERTIFICATION: This water well was constructed, (2) reconstructed, or (3) plugged under my jurisdiction and was completed on (mo/day/year) 10/22/94 and this record is true to the best of my knowledge and belief. Kansas Water Well Contractor's License No. 416 This Water Well Record was completed on (mo/day/yr) 11/28/94 under the business name of Terracon Consultants Inc by (signature) Richard D. Murray