


1 LOCATION OF WATER WELL: Fraction NE 1/4 SE 1/4 SW 1/4 Section Number 31 Township Number T 11 S Range Number R 15 W
 County: Shawnee

Distance and direction from nearest town or city street address of well if located within city?
2.2 miles west of 10th & Wanamaker 1/2 mile south on Indian Hills Rd.

2 WATER WELL OWNER: Indian Hills Landfill (GP-4)
 RR#, St. Address, Box #: 1300 SW Indian Hills Rd
 City, State, ZIP Code: Topeka Ks.
 Board of Agriculture, Division of Water Resources
 Application Number:

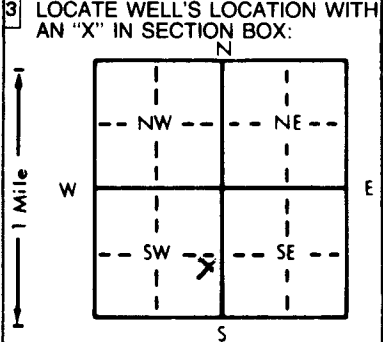

4 DEPTH OF COMPLETED WELL: 32 ft. ELEVATION: 1031.98
 Depth(s) Groundwater Encountered 1. — ft. 2. — ft. 3. — ft.
 WELL'S STATIC WATER LEVEL — ft. below land surface measured on mo/day/yr —
 Pump test data: Well water was — ft. after — hours pumping — gpm
 Est. Yield — gpm: Well water was — ft. after — hours pumping — gpm
 Bore Hole Diameter: 5 7/8 in. to 3 3/4 ft., and — in. to — ft.
 WELL WATER TO BE USED AS: 5 Public water supply 8 Air conditioning 11 Injection well
 1 Domestic 3 Feedlot 6 Oil field water supply 9 Dewatering 12 Other (Specify below)
 2 Irrigation 4 Industrial 7 Lawn and garden only 10 Monitoring well Gas Probe
 Was a chemical/bacteriological sample submitted to Department? Yes — No X; If yes, mo/day/yr sample was submitted
 Water Well Disinfected? Yes — No X

5 TYPE OF BLANK CASING USED: 5 Wrought iron 8 Concrete tile CASING JOINTS: Glued — Clamped —
 1 Steel 3 RMP (SR) 6 Asbestos-Cement 9 Other (specify below) Welded —
 2 PVC 4 ABS 7 Fiberglass Threaded X
 Blank casing diameter 1 in. to 10 ft., Dia — in. to — ft., Dia — in. to — ft.
 Casing height above land surface 30 in., weight Sch 40 lbs./ft. Wall thickness or gauge No. —

TYPE OF SCREEN OR PERFORATION MATERIAL: 7 PVC 10 Asbestos-cement
 1 Steel 3 Stainless steel 5 Fiberglass 8 RMP (SR) 11 Other (specify) —
 2 Brass 4 Galvanized steel 6 Concrete tile 9 ABS 12 None used (open hole)
 SCREEN OR PERFORATION OPENINGS ARE: 5 Gauzed wrapped 8 Saw cut 11 None (open hole)
 1 Continuous slot 3 Mill slot 6 Wire wrapped 9 Drilled holes
 2 Louvered shutter 4 Key punched 7 Torch cut 10 Other (specify) —
 SCREEN-PERFORATED INTERVALS: From 10.0 ft. to 30.0 ft., From — ft. to — ft.
 From — ft. to — ft., From — ft. to — ft.
 GRAVEL PACK INTERVALS: From 8.0 ft. to 32.0 ft., From — ft. to — ft.
 From — ft. to — ft., From — ft. to — ft.

6 GROUT MATERIAL: 1 Neat cement 2 2 Cement grout 3 Bentonite 4 Other —
 Grout Intervals: From 0-0 ft. to 5.0 ft., From 5.0 ft. to 8.0 ft., From — ft. to — ft.
 What is the nearest source of possible contamination: 10 Livestock pens 14 Abandoned water well
 1 Septic tank 4 Lateral lines 7 Pit privy 11 Fuel storage 15 Oil well/Gas well
 2 Sewer lines 5 Cess pool 8 Sewage lagoon 12 Fertilizer storage 18 Other (specify below)
 3 Watertight sewer lines 6 Seepage pit 9 Feedyard 13 Insecticide storage Landfill
 Direction from well? How many feet?

FROM	TO	LITHOLOGIC LOG	FROM	TO	PLUGGING INTERVALS
0.0	1.5	L-cl DK Br an Lt O1 Br			
1.5	2.5	L-cl DK Br			
2.5	6.5	L-cl yell Rd			
6.5	7.0	L-cl yell			
7.0	12.5	L/s. DK yell ORG.			
12.5	13.0	4S O1 Br			
13.0	28.0	siltstone & claystone - LT BIGR			
28.0	32.0	sandstone Gr Org. to DK yell Org.			

7 CONTRACTOR'S OR LANDOWNER'S CERTIFICATION: This water well was 1 constructed, (2) reconstructed, or (3) plugged under my jurisdiction and was completed on (mo/day/year) 10/25/94 and this record is true to the best of my knowledge and belief. Kansas Water Well Contractor's License No. 416 This Water Well Record was completed on (mo/day/yr) 11/29/94 under the business name of Terraco Consultants Inc by (signature) Richard A. Murphy