


1 LOCATION OF WATER WELL: Fraction SE 1/4 SE 1/4 SW 1/4 Section Number 31 Township Number T 11 S Range Number R 15 W
 County: Shawnee

Distance and direction from nearest town or city street address of well if located within city?
2.2 miles west of 10th Wainmaker 1/2 mile south on Indian Hills Rd

2 WATER WELL OWNER: Indian Hills Landfill (OW-04)
 RR#, St. Address, Box #: 1200 SW Indian Hills Rd Board of Agriculture, Division of Water Resources
 City, State, ZIP Code: Topeka KS. Application Number:

3 LOCATE WELL'S LOCATION WITH AN "X" IN SECTION BOX:

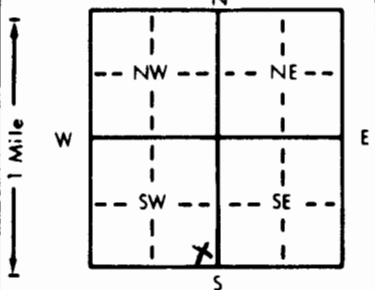

4 DEPTH OF COMPLETED WELL: 50 ft. ELEVATION: 1030.82
 Depth(s) Groundwater Encountered: 1. 779 ft. below ft. 2. — ft. 3. — ft.
 WELL'S STATIC WATER LEVEL: 779 ft. below ft. below land surface measured on mo/day/yr

Pump test data: Well water was — ft. after — hours pumping — gpm
 Est. Yield — gpm: Well water was — ft. after — hours pumping — gpm
 Bore Hole Diameter 5 7/8 in. to 50 ft., and — in. to — ft.
 WELL WATER TO BE USED AS:
 1 Domestic 3 Feedlot 6 Oil field water supply 9 Dewatering 11 Injection well
 2 Irrigation 4 Industrial 7 Lawn and garden only 10 Monitoring well 12 Other (Specify below)
 Was a chemical/bacteriological sample submitted to Department? Yes — No ; If yes, mo/day/yr sample was submitted

5 TYPE OF BLANK CASING USED:
 1 Steel 3 RMP (SR) 5 Wrought iron 8 Concrete tile CASING JOINTS: Glued — Clamped —
 2 PVC 4 ABS 6 Asbestos-Cement 9 Other (specify below) Welded —
 Blank casing diameter 2 in. to 44.5 ft. Dia — in. to — ft. Dia — in. to — ft.
 Casing height above land surface 30 in. weight sch 40 lbs./ft. Wall thickness or gauge No. —

TYPE OF SCREEN OR PERFORATION MATERIAL:
 1 Steel 3 Stainless steel 5 Fiberglass 8 RMP (SR) 10 Asbestos-cement
 2 Brass 4 Galvanized steel 6 Concrete tile 9 ABS 11 Other (specify) —
 12 None used (open hole)
 SCREEN OR PERFORATION OPENINGS ARE:
 1 Continuous slot 3 Mill slot 5 Gauzed wrapped 8 Saw cut 11 None (open hole)
 2 Louvered shutter 4 Key punched 6 Wire wrapped 9 Drilled holes
 7 Torch cut 10 Other (specify) —

SCREEN-PERFORATED INTERVALS: From 44.5 ft. to 49.4 ft., From — ft. to — ft.
 From — ft. to — ft., From — ft. to — ft.
 GRAVEL PACK INTERVALS: From 39.7 ft. to 50.0 ft., From — ft. to — ft.
 From — ft. to — ft., From — ft. to — ft.

6 GROUT MATERIAL: 1 Neat cement 2 Cement grout 3 Bentonite 4 Other —
 Grout Intervals: From 0.0 ft. to 35.7 ft., From 35.7 ft. to 39.7 ft., From — ft. to — ft.

What is the nearest source of possible contamination:
 1 Septic tank 4 Lateral lines 7 Pit privy 10 Livestock pens 14 Abandoned water well
 2 Sewer lines 5 Cess pool 8 Sewage lagoon 11 Fuel storage 15 Oil well/Gas well
 3 Watertight sewer lines 6 Seepage pit 9 Feedyard 12 Fertilizer storage 16 Other (specify below) Landfill
 13 Insecticide storage

Direction from well? How many feet?

| FROM | TO | LITHOLOGIC LOG | FROM | TO | PLUGGING INTERVALS |
|------|------|------------------|------|----|--------------------|
| 0.0 | 8.6 | Clay Br. | | | |
| 8.6 | 16.5 | limestone | | | |
| 16.5 | 18.0 | clayey shale Gr. | | | |
| 18.0 | 23.0 | siltstone | | | |
| 23.0 | 23.5 | ls | | | |
| 23.5 | 29.0 | siltstone | | | |
| 29.0 | 30.0 | clayey shale | | | |
| 30.0 | 36.0 | siltstone | | | |
| 36.0 | 45.0 | clayey shale | | | |
| 45.0 | 46.8 | ls | | | |
| 46.8 | 48.5 | clayey shale Gr | | | |
| 48.5 | 49.0 | ls | | | |
| 49.0 | 49.7 | Coal Blk. | | | |
| 49.7 | 50.0 | clayey shale Gr. | | | |

7 CONTRACTOR'S OR LANDOWNER'S CERTIFICATION: This water well was constructed, (2) reconstructed, or (3) plugged under my jurisdiction and was completed on (mo/day/year) 10/20/94 and this record is true to the best of my knowledge and belief. Kansas Water Well Contractor's License No. 416. This Water Well Record was completed on (mo/day/yr) 11/28/94 under the business name of Tetracon Consultants Inc by (signature) Richard Denny

INSTRUCTIONS: Use typewriter or ball point pen. PLEASE PRESS FIRMLY and PRINT clearly. Please fill in blanks, underline or circle the correct answers. Send top three copies to Kansas Department of Health and Environment, Bureau of Water, Topeka, Kansas 66620-0001. Telephone: 913-296-5545. Send one to WATER WELL OWNER and retain one for your records.

OFFICE USE ONLY

T

R

EW

SEC.

1/4

1/4

1/4