


Distance and direction from nearest town or city street address of well if located within city?
1221 SW 6th, Topeka, KS.

2 WATER WELL OWNER: **Kenneth Cowan**
 RR#, St. Address, Box #: **1221 SW 6th**
 City, State, ZIP Code: **Topeka, KS.**
 Board of Agriculture, Division of Water Resources
 Application Number:

3 LOCATE WELL'S LOCATION WITH AN "X" IN SECTION BOX:

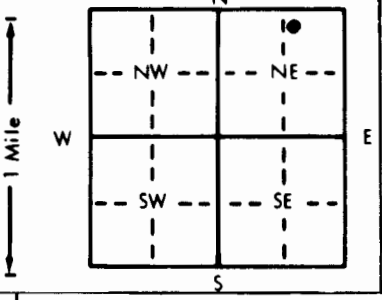

4 DEPTH OF COMPLETED WELL: **19'3"** ft. ELEVATION:
 Depth(s) Groundwater Encountered 1. **10'** ft. 2. ft. 3. ft.
 WELL'S STATIC WATER LEVEL: **8.05'** ft. below land surface measured on mo/day/yr **5-19-95**
 Pump test data: Well water was ft. after hours pumping gpm
 Est. Yield gpm: Well water was ft. after hours pumping gpm
 Bore Hole Diameter: **8 1/2"** in. to **19'3"** ft., and in. to ft.
 WELL WATER TO BE USED AS:
 1 Domestic 3 Feedlot 6 Oil field water supply 9 Dewatering 12 Other (Specify below)
 2 Irrigation 4 Industrial 7 Lawn and garden only **10** Monitoring well
 Was a chemical/bacteriological sample submitted to Department? Yes No **X**; If yes, mo/day/yr sample was submitted
 Water Well Disinfected? Yes **No**

5 TYPE OF BLANK CASING USED:
 1 Steel 3 RMP (SR) 5 Wrought iron 8 Concrete tile CASING JOINTS: Glued Clamped
2 PVC 4 ABS 6 Asbestos-Cement 9 Other (specify below) Welded
 7 Fiberglass Threaded **X**
 Blank casing diameter: **2.375** in. to **9'** ft., Dia. in. to ft., Dia. in. to SDR **13** ft.
 Casing height above land surface: **Flush Mt.** in., weight lbs./ft. Wall thickness or gauge No. **SCH. 40**

TYPE OF SCREEN OR PERFORATION MATERIAL:
 1 Steel 3 Stainless steel 5 Fiberglass 8 RMP (SR) 10 Asbestos-cement
 2 Brass 4 Galvanized steel 6 Concrete tile 9 ABS 11 Other (specify)
 12 None used (open hole)

SCREEN OR PERFORATION OPENINGS ARE:
 1 Continuous slot **3 Mill slot** 5 Gauzed wrapped 8 Saw cut 11 None (open hole)
 2 Louvered shutter 4 Key punched 6 Wire wrapped 9 Drilled holes
 7 Torch cut 10 Other (specify)

SCREEN-PERFORATED INTERVALS: From **19'** ft. to **9'** ft., From ft. to ft.
 From ft. to ft., From ft. to ft.
 GRAVEL PACK INTERVALS: From **19'3"** ft. to **8'** ft., From ft. to ft.
 From ft. to ft., From ft. to ft.

6 GROUT MATERIAL: 1 Neat cement 2 Cement grout 3 Bentonite 4 Other
 Grout Intervals: From **8'** ft. to **3'** ft., From **3'** ft. to **0'** ft., From ft. to ft.
 What is the nearest source of possible contamination:
 1 Septic tank 4 Lateral lines 7 Pit privy **11** Fuel storage **Productive** Oil well/Gas well
 2 Sewer lines 5 Cess pool 8 Sewage lagoon 12 Fertilizer storage 16 Other (specify below)
 3 Watertight sewer lines 6 Seepage pit 9 Feedyard 13 Insecticide storage
 Direction from well? **In Product Island location** How many feet? **0'**

FROM	TO	LITHOLOGIC LOG	FROM	TO	PLUGGING INTERVALS
0	.50	Concrete			
.50	3	Fine-coarse grained sand fill.			
3	6	Blue gray mottled clay, moist, mod. odor, med. plasticity.			
6	16	Blue gray-olive sandy clay, moist, mod. odor, med. plasticity, fine-coarse grained sand & gravel, dk gray sandy banding.			
16	18.50	Yellow brn silty clay to shaley clay, moist to wet, mottled, highly plastic, odor.			
18.50	19'3	Limestone.			

7 CONTRACTOR'S OR LANDOWNER'S CERTIFICATION: This water well was (1) **Constructed** (2) reconstructed, or (3) plugged under my jurisdiction and was completed on (mo/day/year) **5-15-95** and this record is true to the best of my knowledge and belief. Kansas Water Well Contractor's License No. **539**. This Water Well Record was completed on (mo/day/year) **5-23-95** under the business name of **JB Environmental Drilling** by (signature) **James Beebe**