


1 LOCATION OF WATER WELL: County: Shawnee Fraction NW 1/4 NE 1/4 NE 1/4 Section Number 36 Township Number T 11 S Range Number R 15 E/W

Distance and direction from nearest town or city street address of well if located within city? 1221 SW 6th, Topeka, KS.

2 WATER WELL OWNER: Kenneth Cowan
 RR#, St. Address, Box #: 1221 SW 6th
 City, State, ZIP Code: Topeka, KS.

Board of Agriculture, Division of Water Resources
 Application Number:

3 LOCATE WELL'S LOCATION WITH AN "X" IN SECTION BOX:

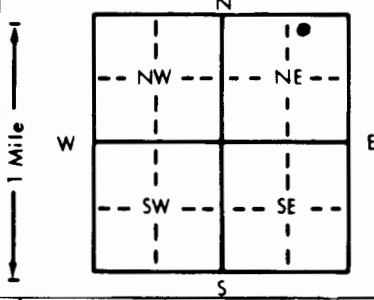

4 DEPTH OF COMPLETED WELL: 20' ft. ELEVATION:

Depth(s) Groundwater Encountered 1. 12' ft. 2. ft. 3. ft.
 WELL'S STATIC WATER LEVEL 8.65 ft. below land surface measured on mo/day/yr 5-19-95
 Pump test data: Well water was ft. after hours pumping gpm
 Est. Yield gpm: Well water was ft. after hours pumping gpm
 Bore Hole Diameter 8 1/2 in. to 20' ft. and in. to ft.
 WELL WATER TO BE USED AS:
 1 Domestic 3 Feedlot 6 Oil field water supply 9 Dewatering 12 Other (Specify below)
 2 Irrigation 4 Industrial 7 Lawn and garden only 10 Monitoring well
 Was a chemical/bacteriological sample submitted to Department? Yes No X; If yes, mo/day/yr sample was submitted
 Water Well Disinfected? Yes No

5 TYPE OF BLANK CASING USED:
 1 Steel 3 RMP (SR) 5 Wrought iron 8 Concrete tile CASING JOINTS: Glued Clamped
 2 PVC 4 ABS 6 Asbestos-Cement 9 Other (specify below) Welded
 7 Fiberglass Threaded X

Blank casing diameter 2.375 in. to 10' ft., Dia in. to SDR 13 ft.
 Casing height above land surface Flush Mt. in., weight lbs./ft. Wall thickness or gauge No. SCH 40

TYPE OF SCREEN OR PERFORATION MATERIAL:
 1 Steel 3 Stainless steel 5 Fiberglass 8 RMP (SR) 10 Asbestos-cement
 2 Brass 4 Galvanized steel 6 Concrete tile 9 ABS 11 Other (specify)
 12 None used (open hole)

SCREEN OR PERFORATION OPENINGS ARE:
 1 Continuous slot 3 Mill slot 5 Gauzed wrapped 8 Saw cut 11 None (open hole)
 2 Louvered shutter 4 Key punched 6 Wire wrapped 9 Drilled holes
 7 Torch cut 10 Other (specify)

SCREEN-PERFORATED INTERVALS: From 20' ft. to 10' ft., From ft. to ft.
 GRAVEL PACK INTERVALS: From 20' ft. to 8' ft., From ft. to ft.

6 GROUT MATERIAL: 1 Neat cement 2 Cement grout 3 Bentonite 4 Other
 Grout Intervals: From 8' ft. to 4' ft., From 4' ft. to 0' ft., From ft. to ft.

What is the nearest source of possible contamination:
 1 Septic tank 4 Lateral lines 7 Pit privy 10 Livestock pens 14 Abandoned water well
 2 Sewer lines 5 Cess pool 8 Sewage lagoon 11 Fuel storage waste oil 15 Oil well/Gas well
 3 Watertight sewer lines 6 Seepage pit 9 Feedyard 12 Fertilizer storage 16 Other (specify below)
 13 Insecticide storage

Direction from well? In Old Pit How many feet? 0

FROM	TO	LITHOLOGIC LOG	FROM	TO	PLUGGING INTERVALS
0	3	Grass-dk brn clay w/ ls.rx. gravel, moist, no odor, organics.			
3	5.25	Fine-coarse grained sand, dry, fill, poorly sorted, no odor.			
5.25	10.50	Gray-gray brn oxide stained & banded clay, med plasticity, moist, soft, no odor.			
10.50	17	Brn sandy clay to clayey sand, moist to wet at 13', fine-coarse grained sand.			
17	20	Olive gravelly sandy clay to shaley clay, moist, highly plastic, no odor.			

7 CONTRACTOR'S OR LANDOWNER'S CERTIFICATION: This water well was (1) constructed, (2) reconstructed, or (3) plugged under my jurisdiction and was completed on (mo/day/year) 5-15-95 and this record is true to the best of my knowledge and belief. Kansas Water Well Contractor's License No. 539 This Water Well Record was completed on (mo/day/year) 5-23-95 under the business name of JB Environmental Drilling by (signature) James Bieker

OFFICE USE ONLY
T
R
EW
SEC
1/4
1/4