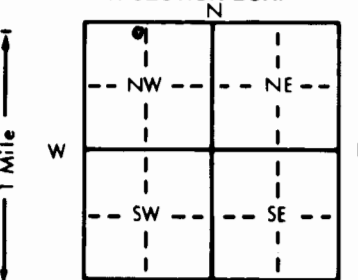


Distance and direction from nearest town or city street address of well if located within city?
 2201 SW 6th, Topeka, KS.

2 WATER WELL OWNER: Coastal Mart INC
 RR#, St. Address, Box #: 110 S. Main Suite 500 Board of Agriculture, Division of Water Resources
 City, State, ZIP Code: Wichita, KS. 67202 Application Number:

3 LOCATE WELL'S LOCATION WITH AN "X" IN SECTION BOX:

 4 DEPTH OF COMPLETED WELL: 15' ft. ELEVATION:
 Depth(s) Groundwater Encountered 1. - ft. 2. - ft. 3. - ft.
 WELL'S STATIC WATER LEVEL 4.83 ft. below land surface measured on mo/day/yr 5-19-95
 Pump test data: Well water was - ft. after - hours pumping - gpm
 Est. Yield - gpm; Well water was - ft. after - hours pumping - gpm
 Bore Hole Diameter 8 1/2 in. to 15' ft., and - in. to - ft.
 WELL WATER TO BE USED AS:
 1 Domestic 3 Feedlot 6 Oil field water supply 8 Air conditioning 11 Injection well
 2 Irrigation 4 Industrial 7 Lawn and garden only 10 Monitoring well 12 Other (Specify below)
 Was a chemical/bacteriological sample submitted to Department? Yes No X; If yes, mo/day/yr sample was submitted
 Water Well Disinfected? Yes No

5 TYPE OF BLANK CASING USED:
 1 Steel 3 RMP (SR) 5 Wrought iron 8 Concrete tile CASING JOINTS: Glued - Clamped -
 2 PVC 4 ABS 6 Asbestos-Cement 9 Other (specify below) Welded -
 Blank casing diameter 2.375 in. to 4.9" ft., Dia. in. to - ft., Dia. in. to SDR 13 ft.
 Casing height above land surface Flush Mt. in., weight - lbs./ft. Wall thickness or gauge No. Sch 40
 TYPE OF SCREEN OR PERFORATION MATERIAL:
 1 Steel 3 Stainless steel 5 Fiberglass 7 PVC 10 Asbestos-cement
 2 Brass 4 Galvanized steel 6 Concrete tile 9 ABS 11 Other (specify) -
 12 None used (open hole)
 SCREEN OR PERFORATION OPENINGS ARE:
 1 Continuous slot 3 Mill slot 5 Gauzed wrapped 8 Saw cut 11 None (open hole)
 2 Louvered shutter 4 Key punched 6 Wire wrapped 9 Drilled holes
 7 Torch cut 10 Other (specify) -
 SCREEN-PERFORATED INTERVALS: From 14'9" ft. to 4'9" ft., From - ft. to - ft.
 GRAVEL PACK INTERVALS: From 15' ft. to 4'5" ft., From - ft. to - ft.

6 GROUT MATERIAL: 1 Neat cement 2 Cement grout 3 Bentonite 4 Other -
 Grout Intervals: From 4'5" ft. to 3'5" ft., From 3'5" ft. to 0' ft., From - ft. to - ft.
 What is the nearest source of possible contamination:
 1 Septic tank 4 Lateral lines 7 Pit privy 10 Livestock pens 14 Abandoned water well
 2 Sewer lines 5 Cess pool 8 Sewage lagoon 11 Fuel storage 15 Oil well/Gas well
 3 Watertight sewer lines 6 Seepage pit 9 Feedyard 12 Fertilizer storage 16 Other (specify below)
 13 Insecticide storage
 Direction from well? West How many feet? 20'

FROM	TO	LITHOLOGIC LOG	FROM	TO	PLUGGING INTERVALS
0	1	Concrete			
1	5	Blue gray silty clay w/ oxide staining & mottling, moist, med to low plasticity, slight odor.			
5	9.50	Olive green silty clay w/ dk gray clay mottling & banding, oxide staining, moist, med plasticity, small ls. rx. gravel, coarse to pebble size at 9'.			
9.50	10	Limestone layer, weathered, fractured.			
10	15	Olive gray-yellowish brn dry shale, no odor, firm.			

7 CONTRACTOR'S OR LANDOWNER'S CERTIFICATION: This water well was (1) constructed, (2) reconstructed, or (3) plugged under my jurisdiction and was completed on (mo/day/year) 5-18-95 and this record is true to the best of my knowledge and belief. Kansas Water Well Contractor's License No. 539 This Water Well Record was completed on (mo/day/yr) 5-23-95 under the business name of JB Environmental Drilling by (signature) James Becker