


1 LOCATION OF WATER WELL: Fraction NE 1/4 NE 1/4 SE 1/4 Section Number 5 Township Number T 11 S Range Number R 16 E/W
 County: SHAWNEE

Distance and direction from nearest town or city street address of well if located within city?
 1 1/2 north, 1 east of Topeka

2 WATER WELL OWNER: Stan Teeter
 RR#, St. Address, Box # : 4207 NE Kimball Board of Agriculture, Division of Water Resources
 City, State, ZIP Code : Topeka, KS Application Number:

3 LOCATE WELL'S LOCATION WITH AN "X" IN SECTION BOX: 4 DEPTH OF COMPLETED WELL... 60' ft. ELEVATION:

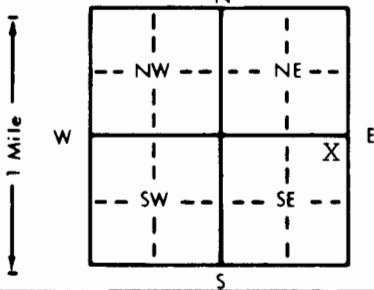

Depth(s) Groundwater Encountered 1... 13' ft. 2... ft. 3... ft.
 WELL'S STATIC WATER LEVEL... 9' ft. below land surface measured on mo/day/yr... 4-04-96
 Pump test data: Well water was... ft. after... hours pumping... gpm
 Est. Yield... 4... gpm: Well water was... ft. after... hours pumping... gpm
 Bore Hole Diameter... 12" in. to... ft., and... in. to... ft.
 WELL WATER TO BE USED AS: 5 Public water supply 8 Air conditioning 11 Injection well
 1 Domestic 3 Feedlot 6 Oil field water supply 9 Dewatering 12 Other (Specify below)
 2 Irrigation 4 Industrial 7 Lawn and garden only 10 Monitoring well
 Was a chemical/bacteriological sample submitted to Department? Yes... No... X... If yes, mo/day/yr sample was submitted
 Water Well Disinfected? Yes... X... No

5 TYPE OF BLANK CASING USED: 5 Wrought iron 8 Concrete tile CASING JOINTS: Glued... X... Clamped...
 1 Steel 3 RMP (SR) 6 Asbestos-Cement 9 Other (specify below) Welded...
 2 PVC 4 ABS 7 Fiberglass Threaded...

Blank casing diameter... 5" in. to 0-10 ft., Dia 5" in. to 30-50 ft., Dia 5" in. to 55-60 ft.
 Casing height above land surface... 24" in., weight... 2.82 lbs./ft. Wall thickness or gauge No. .258

TYPE OF SCREEN OR PERFORATION MATERIAL: 7 PVC 10 Asbestos-cement
 1 Steel 3 Stainless steel 5 Fiberglass 8 RMP (SR) 11 Other (specify)
 2 Brass 4 Galvanized steel 6 Concrete tile 9 ABS 12 None used (open hole)

SCREEN OR PERFORATION OPENINGS ARE: 5 Gauzed wrapped 8 Saw cut 11 None (open hole)
 1 Continuous slot 3 Mill slot 6 Wire wrapped 9 Drilled holes
 2 Louvered shutter 4 Key punched 7 Torch cut 10 Other (specify)

SCREEN-PERFORATED INTERVALS: From... 10 ft. to... 30 ft., From... ft. to... ft.
 From... 50 ft. to... 55 ft., From... ft. to... ft.

GRAVEL PACK INTERVALS: From... 10 ft. to... 60 ft., From... ft. to... ft.
 From... ft. to... ft., From... ft. to... ft.

6 GROUT MATERIAL: 1 Neat cement 2 Cement grout 3 Bentonite 4 Other
 Grout Intervals: From... 0 ft. to... 10 ft., From... ft. to... ft., From... ft. to... ft.

What is the nearest source of possible contamination:
 1 Septic tank 4 Lateral lines 7 Pit privy 10 Livestock pens 14 Abandoned water well
 2 Sewer lines 5 Cess pool 8 Sewage lagoon 11 Fuel storage 15 Oil well/Gas well
 3 Watertight sewer lines 6 Seepage pit 9 Feedyard 12 Fertilizer storage 16 Other (specify below)
 creek

Direction from well? north How many feet? 50'

FROM	TO	LITHOLOGIC LOG	FROM	TO	PLUGGING INTERVALS
0	4	Top Soil			
4	10	Clay-Brown			
10	13	Chert Gravel, Fine Sand-Coarse Sand			
13	18	Clay-Brown			
18	25	Clay-Blue			
25	26	Cherty Limestone-Loose			
26	47	Shale-Grey			
47	48	Limestone-Grey			
48	54	Sandstone-Grey			
54	60	Shale-Grey			

NOTE: 4-08-96 Permission to shallow grout from Don Taylor.

7 CONTRACTOR'S OR LANDOWNER'S CERTIFICATION: This water well was (1) constructed, (2) reconstructed, or (3) plugged under my jurisdiction and was completed on (mo/day/year) 4-04-96 and this record is true to the best of my knowledge and belief. Kansas Water Well Contractor's License No. 182 This Water Well Record was completed on (mo/day/yr) 4-17-96 under the business name of STRADER DRILLING CO., INC. by (signature) Dale Baker

OFFICE USE ONLY

T

R

EW

SEC

1/4

1/4

1/4