

CORRECTION(S) TO WATER WELL RECORD (WWC-5)

(to rectify lacking or incorrect information)

County: Shawnee

Location listed as:

Location changed to:

Section-Township-Range: 36-11S-17E36-11S-16EFraction ($\frac{1}{4}$ $\frac{1}{4}$ $\frac{1}{4}$): NW NE NWNW NE NW

Other changes: Initial statements: _____

Changed to: _____

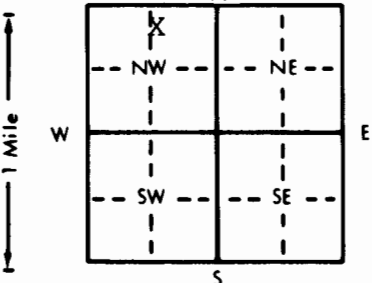
Comments: Range changed from 17E to 16Everification method: County maps, location information on WWC5initials: MS date: 7-18-06submitted by: Kansas Geological Survey, Data Resources Library, 1930 Constant Ave., Lawrence, KS 66047-3726
to: Kansas Dept of Health & Environment, Bureau of Water, 1000 SW Jackson, Suite 420, Topeka, KS 66612-1367.

1 LOCATION OF WATER WELL: Fraction NW 1/4 NE 1/4 NW 1/4 Section Number 36 Township Number T 11 S Range Number R 17 E/W
 County: SHAWNEE

Distance and direction from nearest town or city street address of well if located within city?

1 1/2 east of Topeka

2 WATER WELL OWNER: Capital City Pallet, Inc.
 RR#, St. Address, Box #: 290 Goodell P.O. Box 1573 Board of Agriculture, Division of Water Resources
 City, State, ZIP Code: Topeka, KS 66601 Application Number:

3 LOCATE WELL'S LOCATION WITH AN "X" IN SECTION BOX:  4 DEPTH OF COMPLETED WELL... 40 ft. ELEVATION: ...
 Depth(s) Groundwater Encountered 1. ... ft. 2. ... ft. 3. ... ft.
 WELL'S STATIC WATER LEVEL . 19' ft. below land surface measured on mo/day/yr ~~XX~~ 4-4-96
 Pump test data: Well water was ... ft. after ... hours pumping ... gpm
 Est. Yield . 50 gpm: Well water was ... ft. after ... hours pumping ... gpm
 Bore Hole Diameter. 12" in. to ... ft., and ... in. to ... ft.
 WELL WATER TO BE USED AS: 5 Public water supply 8 Air conditioning 11 Injection well
 1 Domestic 3 Feedlot 6 Oil field water supply 9 Dewatering 12 Other (Specify below)
 2 Irrigation 4 Industrial 7 Lawn and garden only 10 Monitoring well
 Was a chemical/bacteriological sample submitted to Department? Yes ... No ; If yes, mo/day/yr sample was submitted
 Water Well Disinfected? Yes No

5 TYPE OF BLANK CASING USED: 5 Wrought iron 8 Concrete tile CASING JOINTS: Glued Clamped ...
 1 Steel 3 RMP (SR) 6 Asbestos-Cement 9 Other (specify below) Welded ...
 2 PVC 4 ABS 7 Fiberglass Threaded ...
 Blank casing diameter . 5" in. to . 0-15 ft., Dia . in. to . ft., Dia . in. to . ft.
 Casing height above land surface . 24" in., weight . 2.82 lbs./ft. Wall thickness or gauge No. . 258
 TYPE OF SCREEN OR PERFORATION MATERIAL: 7 PVC 10 Asbestos-cement
 1 Steel 3 Stainless steel 5 Fiberglass 8 RMP (SR) 11 Other (specify) ...
 2 Brass 4 Galvanized steel 6 Concrete tile 9 ABS 12 None used (open hole)
 SCREEN OR PERFORATION OPENINGS ARE: 5 Gauzed wrapped 8 Saw cut 11 None (open hole)
 1 Continuous slot 3 Mill slot 6 Wire wrapped 9 Drilled holes
 2 Louvered shutter 4 Key punched 7 Torch cut 10 Other (specify) ...
 SCREEN-PERFORATED INTERVALS: From . 15 ft. to . 40 ft., From . ft. to . ft.
 GRAVEL PACK INTERVALS: From . 24 ft. to . 40 ft., From . ft. to . ft.

6 GROUT MATERIAL: 1 Neat cement 2 Cement grout 3 Bentonite 4 Other ...
 Grout Intervals: From . 4 ft. to . 24 ft., From . ft. to . ft., From . ft. to . ft.
 What is the nearest source of possible contamination: 10 Livestock pens 14 Abandoned water well
 1 Septic tank 4 Lateral lines 7 Pit privy 11 Fuel storage 15 Oil well/Gas well
 2 Sewer lines 5 Cess pool 8 Sewage lagoon 12 Fertilizer storage 16 Other (specify below)
 3 Watertight sewer lines 6 Seepage pit 9 Feedyard 13 Insecticide storage
 Direction from well? north How many feet? 300'

FROM	TO	LITHOLOGIC LOG	FROM	TO	PLUGGING INTERVALS
0	2	Top Soil			
2	17	Clay-Brown-Silty			
17	29	Fine Sand-Coarse Sand-Med Gravel, Brown			
29	31	Clay-Blue			
31	38	Fine Sand-Coarse Sand-Med-Pea-Blue			
38	40	Limestone-Grey			

7 CONTRACTOR'S OR LANDOWNER'S CERTIFICATION: This water well was (1) constructed, (2) reconstructed, or (3) plugged under my jurisdiction and was completed on (mo/day/year) 4-04-96 and this record is true to the best of my knowledge and belief. Kansas Water Well Contractor's License No. 182 This Water Well Record was completed on (mo/day/yr) 4-17-96 under the business name of STRADER DRILLING CO., INC. by (signature) Dale Dekran

INSTRUCTIONS: Use typewriter or ball point pen. PLEASE PRESS FIRMLY and PRINT clearly. Please fill in blanks, underline or circle the correct answers. Send top three copies to Kansas Department of Health and Environment, Bureau of Water, Topeka, Kansas 66620-0001. Telephone: 913-296-5545. Send one to WATER WELL OWNER and retain one for your records.