


1 LOCATION OF WATER WELL: County: Shawnee Fraction: NW 1/4 SE 1/4 NW 1/4 Section Number: 31 Township Number: T 11 S Range Number: R 16 EW

Distance and direction from nearest town or city street address of well if located within city?
611 S. Kansas, Topeka, Ks.

2 WATER WELL OWNER: Cohen-Esrey Real Estate Services
 RR#, St. Address, Box #: 400 SW 8th/Capitol Towers 110 Board of Agriculture, Division of Water Resources
 City, State, ZIP Code: Topeka, Ks. 66603 Application Number:

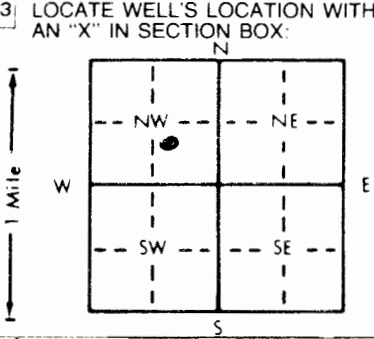

4 DEPTH OF COMPLETED WELL: 16'6" ft. ELEVATION:
 Depth(s) Groundwater Encountered: 1 9'6" ft. 2 _____ ft. 3 _____ ft.
 WELL'S STATIC WATER LEVEL: 9.22 ft. below land surface measured on mo day yr 8-6-97
 Pump test data: Well water was _____ ft. after _____ hours pumping _____ gpm
 Est. Yield _____ gpm: Well water was _____ ft. after _____ hours pumping _____ gpm
 Bore Hole Diameter: 7'6" in. to 16'6" ft., and _____ in. to _____ ft.
 WELL WATER TO BE USED AS:
 5 Public water supply 8 Air conditioning 11 Injection well
 1 Domestic 3 Feedlot 6 Oil field water supply 9 Dewatering 12 Other (Specify below)
 2 Irrigation 4 Industrial 7 Lawn and garden only 10 Monitoring well
 Was a chemical/bacteriological sample submitted to Department? Yes _____ No X If yes, mo day yr sample was submitted _____
 Water Well Disinfected? Yes _____ No X

5 TYPE OF BLANK CASING USED:
 1 Steel 3 RMP (SR) 5 Wrought iron 8 Concrete tile CASING JOINTS: Glued _____ Clamped _____
2 PVC 4 ABS 6 Asbestos-Cement 9 Other (specify below) Welded _____
 7 Fiberglass Threaded: X
 Blank casing diameter: 2.375 in. to 16'6" ft. Dia _____ in. to _____ ft. Dia _____ in. to SDR 13 _____ ft.
 Casing height above land surface: Flush Mt. in. weight _____ lbs./ft. Wall thickness or gauge No. SCH 40
 TYPE OF SCREEN OR PERFORATION MATERIAL:
 1 Steel 3 Stainless steel 5 Fiberglass 8 RMP (SR) 10 Asbestos-cement
 2 Brass 4 Galvanized steel 6 Concrete tile 9 ABS 11 Other (specify) _____
 12 None used (open hole) _____
 SCREEN OR PERFORATION OPENINGS ARE:
 1 Continuous slot 3 Mill slot 5 Gauzed wrapped 8 Saw cut 11 None (open hole)
 2 Louvered shutter 4 Key punched 6 Wire wrapped 9 Drilled holes
 7 Torch cut 10 Other (specify) _____
 SCREEN-PERFORATED INTERVALS: From 16'6" ft. to 6'6" ft. From _____ ft. to _____ ft.
 From _____ ft. to _____ ft. From _____ ft. to _____ ft.
 GRAVEL PACK INTERVALS: From 16'6" ft. to 6' ft. From _____ ft. to _____ ft.
 From _____ ft. to _____ ft. From _____ ft. to _____ ft.

6 GROUT MATERIAL: 1 Neat cement 2 Cement grout 3 Bentonite 4 Other
 Grout Intervals: From 6' ft. to 2' ft. From 2' ft. to 0' ft. From _____ ft. to _____ ft.
 What is the nearest source of possible contamination:
 1 Septic tank 4 Lateral lines 7 Pit privy 10 Livestock pens 14 Abandoned water well
 2 Sewer lines 5 Cess pool 8 Sewage lagoon 11 Fuel storage 15 Oil well/Gas well
3 Watertight sewer lines 6 Seepage pit 9 Feedyard 12 Fertilizer storage 16 Other (specify below) _____
 13 Insecticide storage _____
 Direction from well? East How many feet? 20'

FROM	TO	LITHOLOGIC LOG	FROM	TO	PLUGGING INTERVALS
0	.50	Concrete			
.50	4	Med brn sandy clay fill, moist, no odor, fine sand.			
4	7	Brn-yellow brn clayey sand to weathered sand stone, wet, no odor.			
7	15	Red brick rubble fill at 8', wood debris, wet, no odor.			
15	16'6"	Brn-olive weathered shale, dry, no odor, firm.			

F.M. OK'd by Don Taylor

7 CONTRACTOR'S OR LANDOWNER'S CERTIFICATION: This water well was (constructed) (2) reconstructed, or (3) plugged under my jurisdiction and was completed on (mo/day/year) 8-5-97 and this record is true to the best of my knowledge and belief. Kansas Water Well Contractor's License No. 539 This Water Well Record was completed on (mo/day/yr) 8-11-97 under the business name of JB Environmental by (signature) James Becker

OFFICE USE ONLY

T

R

EW

SEC

1/4

1/4

1/4