


1 LOCATION OF WATER WELL: Fraction **SE 1/4 SW 1/4 SE 1/4** Section Number **20** Township Number **11** Range Number **16-East**  
 County: **Shawnee**

Distance and direction from nearest town or city street address of well if located within city?  
**1907 NE Monroe Street, Topeka, Kansas**

2 WATER WELL OWNER: **Marshall Ticehurst**  
 RR#, St. Address, Box # **1907 NE Monroe Street** Board of Agriculture, Division of Water Resources  
 City, State, ZIP Code : **Topeka, Kansas 66608** Application Number:

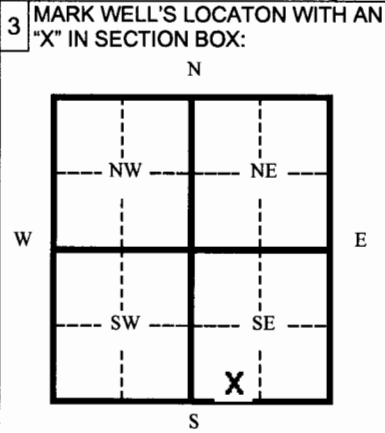

4 DEPTH OF WELL **25.0** ft.  
 WELL'S STATIC WATER LEVEL **22.39** ft.  
 WELL WAS USED AS:  
 1 Domestic 5 Public Water Supply 9 Dewatering  
 2 Irrigation 6 Oil Field Water Supply 10  Monitoring Well  
 3 Feedlot 7 Lawn and Garden (domestic) 11 Injection Well  
 4 Industrial 8 Air Conditioning 12 Other \_\_\_\_\_  
 Was a chemical/bacteriological sample submitted to Department? Yes \_\_\_\_\_ No   
 If yes, mo/day/yr sample was submitted \_\_\_\_\_  
 Water Well Disinfected: Yes \_\_\_\_\_ No

5 TYPE OF BLANK CASING USED:  
 1 Steel 3 RMP (SR) 5 Wrought 7 Fiberglass 9 Other (specify below)  
 2  PVC 4 ABC 6 Asbestos-Cement 8 Concrete Tile  
 Blank casing diameter **2.375** in. Was casing pulled? Yes  No \_\_\_\_\_ If yes, how much? **25.0'**  
 Casing height above or below land surface **Unknown** in. **Well overdrilled to 20'**

6 GROUT PLUG MATERIAL: 1 Neat cement 2 Cement grout 3  Bentonite 4  Other **Soils**  
 Grout Plug Intervals From **20.0** ft. to **1.0** ft. From **1.0** ft. to **0.0** ft. From \_\_\_\_\_ ft. to \_\_\_\_\_ ft.

What is the nearest source of possible contamination:  
 1 Septic tank 6 Seepage pit 11  Fuel storage (former) 16 Other (specify below)  
 2 Sewer lines 7 Pit privy 12 Fertilizer storage  
 3 Watertight sewer lines 8 Sewage lagoon 13 Insecticide storage  
 4 Lateral lines 9 Feedyard 14 Abandoned water well  
 5 Cess Pool 10 Livestock pens 15 Oil well/ Gas well

Direction from well? **West** How many feet? **5**

FROM	TO	CODE	PLUGGING MATERIALS
0.0	1.0		Compacted soils
1.0	20.0		Bentonite chips

7 CONTRACTOR'S OR LANDOWNER'S CERTIFICATION: This water well was plugged under my jurisdiction and was completed on (mo/day/yr) **03/14/05** and this record is true to the best of my knowledge and belief. Kansas Water Well Contractor's License No. **692** This Water Well Record was completed on (mo/day/yr) **04/04/05** under the business name of **Quad State Services, Inc.**  
 by (signature) *[Signature]*

INSTRUCTIONS: Please fill in blanks and circle the correct answers. Send three copies to Kansas Department of Health and Environment, Bureau of Water, 1000 S W Jackson St., Ste. 420, Topeka, Kansas 66620-0001. Telephone: 785-296-3565. Send one to Water Well Owner and retain one for your records.