


1 LOCATION OF WATER WELL: Fraction SW 1/4 NE 1/4 SE 1/4 Section Number 30 Township Number 11 Range Number 16 EW
 County: Shawnee

Distance and direction from nearest town or city street address of well if located within city?
621 W. 1st STREET TOPEKA.

2 WATER WELL OWNER: Union Pacific
Jeff Mc Dermott
 RR #, St. Address, Box #: 1414 Dodge Street, Room 930 Board of Agriculture, Division of Water Resources
 City, State, ZIP Code: Omaha, NE 68179 Application Number:

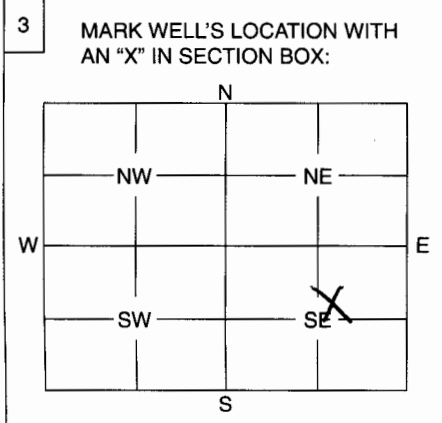

4 DEPTH OF WELL 25.6 ft.
 WELL'S STATIC WATER LEVEL DRY ft.
 WELL WAS USED AS:
 1 Domestic 2 Irrigation 3 Feedlot 4 Industrial 5 Public Water Supply 6 Oil Field Water Supply 7 Domestic (Lawn & Garden) 8 Air Conditioning 9 Dewatering 10 Monitoring Well 11 Injection Well 12 Other
 Was a chemical / bacteriological sample submitted to Department? Yes No X.....
 If yes, mo/day/yr sample was submitted
 Water Well Disinfected: Yes No X.....

5 TYPE OF BLANK CASING USED:
 1 Steel 2 PVC 3 RMP (SR) 4 ABS 5 Wrought 6 Asbestos-Cement 7 Fiberglass 8 Concrete Tile 9 Other (Specify below)
 Blank casing diameter in. Was casing pulled? Yes No If yes, how much
 Casing height above or below land surface in.

6 GROUT PLUG MATERIAL: 1 Neat cement 2 Cement grout 3 Bentonite 4 Other
 Grout Plug Intervals: From 20.3 ft. to 25.6 ft., From ft. to ft., From to ft.
 What is the nearest source of possible contamination:
 1 Septic tank 2 Sewer lines 3 Watertight sewer lines 4 Lateral lines 5 Cess pool 6 Seepage pit 7 Pit privy 8 Sewage lagoon 9 Feedyard 10 Livestock pens 11 Fuel storage 12 Fertilizer storage 13 Insecticide storage 14 Abandoned water well 15 Oil well/Gas well 16 Other (specify below)
 Direction from well? How many feet?

FROM	TO	PLUGGING MATERIALS
<u>3.0</u>	<u>25.6</u>	<u>Bentonite Grout</u>
<u>0</u>	<u>3.0</u>	<u>Native soils</u>

Over drilled to 20'

7 CONTRACTOR'S OF LANDOWNER'S CERTIFICATION: This water well was plugged under my jurisdiction and was completed on (mo/day/year) 4/27/85 and this record is true to the best of my knowledge and belief. Kansas Water Well Contractor's License No. 594 This Water Well Record was completed on (mo/day/year) 5/11/85 under the business name of Celance Great Plains, Inc.
 by (signature) [Signature]

INSTRUCTIONS: Use typewriter or ball point pen. Please press firmly and print clearly. Please fill in blanks, underline or circle the correct answers. Send top three copies to Kansas Department of Health and Environment, Bureau of Water, Geology Section, 1000 SW Jackson St., Ste. 420, Topeka, Kansas 66612-1367. Telephone: 785/296-5522. Send one to Water Well Owner and retain one for your records.