


1 LOCATION OF WATER WELL: Fraction Section Number Township Number Range Number
 County: Shawnee SW 1/4 NE 1/4 SE 1/4 30 11 16 EW

Distance and direction from nearest town or city street address of well if located within city?

621 W. 1st STREET, TOPEKA.

2 WATER WELL OWNER: Union Pacific
Jeff McDermott
 RR #, St. Address, Box #: 1416 Dodge Street, Room 930
 City, State, ZIP Code : Omaha, NE 68179 Board of Agriculture, Division of Water Resources
 Application Number:

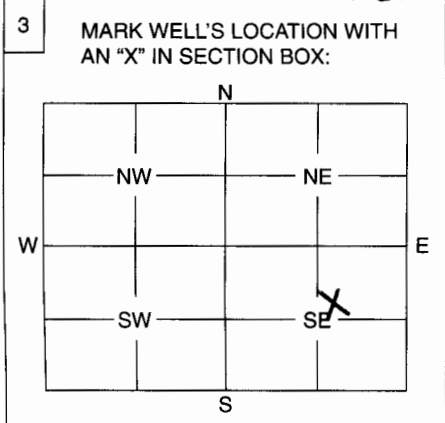

4 DEPTH OF WELL ft.
 WELL'S STATIC WATER LEVEL ft.
 WELL WAS USED AS:
 1 Domestic 2 Irrigation 3 Feedlot 4 Industrial 5 Public Water Supply 6 Oil Field Water Supply 7 Domestic (Lawn & Garden) 8 Air Conditioning 9 Dewatering 10 Monitoring Well 11 Injection Well 12 Other

Was a chemical / bacteriological sample submitted to Department? Yes No X.....
 If yes, mo/day/yr sample was submitted

Water Well Disinfected: Yes No X.....

5 TYPE OF BLANK CASING USED:
 1 Steel 2 PVC 3 RMP (SR) 4 ABS 5 Wrought 6 Asbestos-Cement 7 Fiberglass 8 Concrete Tile 9 Other (Specify below)

Blank casing diameter in. Was casing pulled? Yes No If yes, how much

Casing height above or below land surface in.

6 GROUT PLUG MATERIAL: 1 Neat cement 2 Cement grout 3 Bentonite 4 Other

Grout Plug Intervals: From ft. to ft., From ft. to ft., From to ft.

What is the nearest source of possible contamination:
 1 Septic tank 2 Sewer lines 3 Watertight sewer lines 4 Lateral lines 5 Cess pool 6 Seepage pit 7 Pit privy 8 Sewage lagoon 9 Feedyard 10 Livestock pens 11 Fuel storage 12 Fertilizer storage 13 Insecticide storage 14 Abandoned water well 15 Oil well/Gas well 16 Other (specify below) LUST SITE

Direction from well? How many feet?

FROM	TO	PLUGGING MATERIALS

MW 1 WAS DESTROYED!

7 CONTRACTOR'S OF LANDOWNER'S CERTIFICATION: This water well was plugged under my jurisdiction and was completed on (mo/day/year) 4/27/85 and this record is true to the best of my knowledge and belief. Kansas Water Well Contractor's License No. 514 This Water Well Record was completed on (mo/day/year) 5/11/85 under the business name of Colanco Great Plains, Inc.
 by (signature) [Signature]

INSTRUCTIONS: Use typewriter or ball point pen. Please press firmly and print clearly. Please fill in blanks, underline or circle the correct answers. Send top three copies to Kansas Department of Health and Environment, Bureau of Water, Geology Section, 1000 SW Jackson St., Ste. 420, Topeka, Kansas 66612-1367. Telephone: 785/296-5522. Send one to Water Well Owner and retain one for your records.