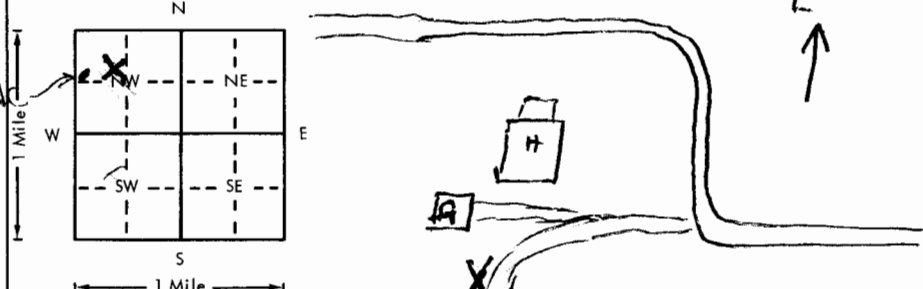


USE TYPEWRITER OR BALL  
POINT PEN-PRESS FIRMLY,  
PRINT CLEARLY.

WATER WELL RECORD  
KSA 82a-1201-1215

Kansas Department of Health and  
Environment-Division of Environment  
(Water well Contractors)  
Topeka, Kansas 66620

1. Location of well:		County <b>JEFFERSON</b>	Fraction <b>SW 1/4 NW 1/4 SE 1/4</b>	Section number <b>24</b>	Township number <b>T 11 S</b>	Range number <b>R 16 E</b>
2. Distance and direction from nearest town or city: Street address of well location if in city:		<b>E OF TOPEKA 7 mi.</b>		3. Owner of well: R.R. or street: City, state, zip code:		
4. Locate with "X" in section below:		Sketch map:		6. Bore hole dia. <b>8</b> in. Completion date <b>4-26-77</b> Well depth <b>40</b> ft.		
				7. Cable tool <input checked="" type="checkbox"/> Rotary <input type="checkbox"/> Driven <input type="checkbox"/> Dug <input type="checkbox"/> Hollow rod <input type="checkbox"/> Jetted <input checked="" type="checkbox"/> Bored <input type="checkbox"/> Reverse rotary		
5. Type and color of material		From To		8. Use: <input type="checkbox"/> Domestic <input type="checkbox"/> Public supply <input type="checkbox"/> Industry <input checked="" type="checkbox"/> Irrigation <input type="checkbox"/> Air conditioning <input type="checkbox"/> Stock <input type="checkbox"/> Lawn <input type="checkbox"/> Oil field water <input type="checkbox"/> Other		
Top soil		1 4		9. Casing: Material <input type="checkbox"/> Height: Above or below Threaded <input type="checkbox"/> Welded <input type="checkbox"/> Surface <b>1 1/2</b> in. RMP <input checked="" type="checkbox"/> PVC <input type="checkbox"/> Weight <input type="checkbox"/> lbs./ft. Dia. <b>5</b> in. to <b>40</b> ft. depth Wall Thickness: inches or Dia. <input type="checkbox"/> in. to <input type="checkbox"/> ft. depth gage No. <b>200</b>		
SANDY SILT (BROWN)		4 6		10. Screen: Manufacturer's name <b>SUN FLOWER</b> Type <b>RMP</b> Dia. <b>5</b> in. Slot/gauze <b>1/8</b> in. Length <b>5</b> ft. Set between <b>30</b> ft. and <b>40</b> ft. Gravel pack? <input checked="" type="checkbox"/> Size range of material <b>5/16</b>		
BLACK SOIL		6 16		11. Static water level: <input type="checkbox"/> mo./day/yr. <b>25</b> ft. below land surface Date <b>4-26-77</b>		
FINE SAND		16 18		12. Pumping level below land surfaces: <b>26</b> ft. after <b>1</b> hrs. pumping <b>16</b> g.p.m. ft. after <input type="checkbox"/> hrs. pumping <input type="checkbox"/> g.p.m. Estimated maximum yield <b>20</b> g.p.m.		
BLACK GRAY SOIL		18 25		13. Water sample submitted: <input type="checkbox"/> Yes <input checked="" type="checkbox"/> No Date <input type="checkbox"/>		
SAND + GRAVEL		25 40		14. Well head completion: <input type="checkbox"/> Pitless adapter <b>12</b> inches above grade		
STREAKED WITH GRAY MUD				15. Well grouted? <input checked="" type="checkbox"/> With: <input checked="" type="checkbox"/> Neat cement <input type="checkbox"/> Bentonite <input type="checkbox"/> Concrete Depth: From <b>2</b> ft. to <b>15</b> ft.		
				16. Nearest source of possible contamination: ft. <b>180</b> Direction <b>E</b> Type <b>S. TANK</b> Well disinfected upon completion? <input checked="" type="checkbox"/> Yes <input type="checkbox"/> No		
				17. Pump: <input type="checkbox"/> Not installed Manufacturer's name <b>GOULDS</b> Model number <b>10EJ</b> HP <b>1/2</b> Volts <b>115</b> Length of drop pipe <b>37</b> ft. capacity <b>10</b> g.p.m. Type: <input checked="" type="checkbox"/> Submersible <input type="checkbox"/> Turbine <input type="checkbox"/> Jet <input type="checkbox"/> Reciprocating <input type="checkbox"/> Centrifugal <input type="checkbox"/> Other		
18. Elevation:		19. Remarks:		20. Water well contractor's certification: This well was drilled under my jurisdiction and this report is true to the best of my knowledge and belief. <b>H. L. PETTIT 333</b> Business name <b>905 N MICHIGAN</b> License No. Address <b>H. L. Pettit</b> Date <b>5-1-77</b> Signed <input type="checkbox"/> Authorized representative		