


USE TYPEWRITER OR BALL POINT PEN-PRESS FIRMLY, PRINT CLEARLY.

WATER WELL RECORD
KSA 82a-1201-1215

Kansas Department of Health and Environment-Division of Environment
(Water well Contractors)
Topeka, Kansas 66620

1. Location of well: County Shawnee Fraction SW 1/4 SW 1/4 Section number 10 Township number T 11 S R 16 E Range number 16

2. Distance and direction from nearest town or city: .3 E OF 3244 N.E. HAPPY HOLLOW Rd. TOPEKA
3. Owner of well: Marvin White
R.R. or street: White Sheet Metal 3244 N.E. Happy Hollow Rd.
City, state, zip code: Topeka, KS 66617

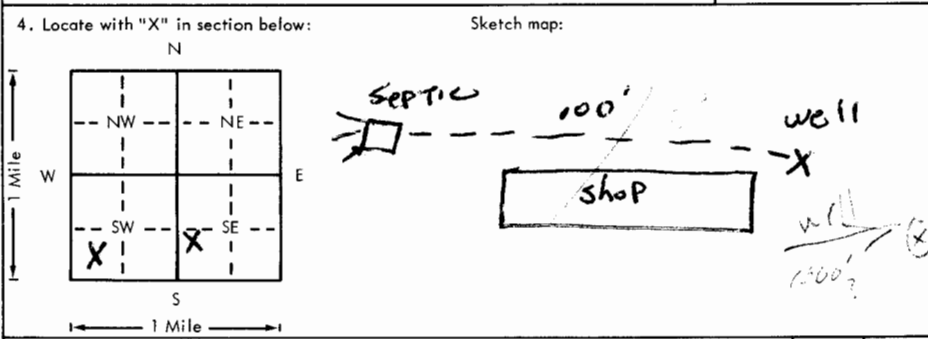

6. Bore hole dia. 12 in. Completion date 4-20-79
Well depth 40 ft.
7. Cable tool Rotary Driven Dug
 Hollow rod Jetted Bored Reverse rotary
8. Use: Domestic Public supply Industry
 Irrigation Air conditioning Stock
 Lawn Oil field water Other
9. Casing: Material PVC Height: Above or below
Threaded Welded Surface 29 in.
RMP PVC 9L Weight 3182 lbs./ft.
Dia. 5 in. to 40 ft. depth Wall Thickness: inches or
Dia. in. to ft. depth gage No. 1350

5. Type and color of material	From	To
Top Soil	0	6
Sandy Clay	6	30
Fine Sand, Coarse Sand, Gravel, water bearing	30	38
Shale, grey	38	40
(Use a second sheet if needed)		

10. Screen: Manufacturer's name Pumpco MPI
Type PVC Dia. 5
Stk/gauze .060 Length 20 ft.
Set between 32 ft. and 40 ft.
Gravel pack? Size range of material 1/4" x 1/8"
11. Static water level: 18 ft. below land surface Date 4-20-79
12. Pumping level below land surfaces:
 ft. after hrs. pumping g.p.m.
 ft. after hrs. pumping g.p.m.
Estimated maximum yield 100 g.p.m.
13. Water sample submitted: mo./day/yr.
 Yes No Date
14. Well head completion: CAP
 Pitless adapter 29 Inches above grade
15. Well grouted?
With: Neat cement Bentonite Concrete
Depth: From 0 ft. to 10 ft.
16. Nearest source of possible contamination:
ft. 100 Direction W Type SEPTIC
Well disinfected upon completion? Yes No
17. Pump: Not installed
Manufacturer's name
Model number HP Volts
Length of drop pipe ft. capacity g.p.m.
Type:
 Submersible Turbine
 Jet Reciprocating
 Centrifugal Other

18. Elevation: 970 ft.
Topography:
 Hill
 Slope
 Upland
 Valley

19. Remarks: 974 ft. owner TO INSTALL SLAB

20. Water well contractor's certification:
This well was drilled under my jurisdiction and this report is true to the best of my knowledge and belief.
STRADER Drilling Co Inc 182
Business name License No.
Address RT 1 Holton KS
Signed Dale Askren Date 4-23-79
Authorized representative

T 11 S R 16 E 15 SW 1/4