84 — R

USE TYPEWRITER OR BALL POINT PEN-PRESS FIRMLY, PRINT CLEARLY.

CDA

WATER WELL RECORD
KSA 82a-1201-1215

Kansas Department of Health and Environment-Division of Environment (Water well Contractors) Topeka, Kansas 66620

NE ~~NE~~ SE SW

1. Location of well:	County	Fraction	Section number	Township number	Range number
	SHAWNEE	~~NE-NW-SE~~ ~~NW~~ 1/4 ~~SE~~ 1/4 ~~SW~~ 1/4	17	T 11 S	R 16 E

2. Distance and direction from nearest town or city: 121 Highway 24 TOPEKA CITY
Street address of well location if in city:

3. Owner of well: NOD-AWAY MOTEL
R.R. or street: 121- NW Hy 24
City, state, zip code: TOPEKA KAN.

4. Locate with "X" in section below: Sketch map: Hy 24 → W

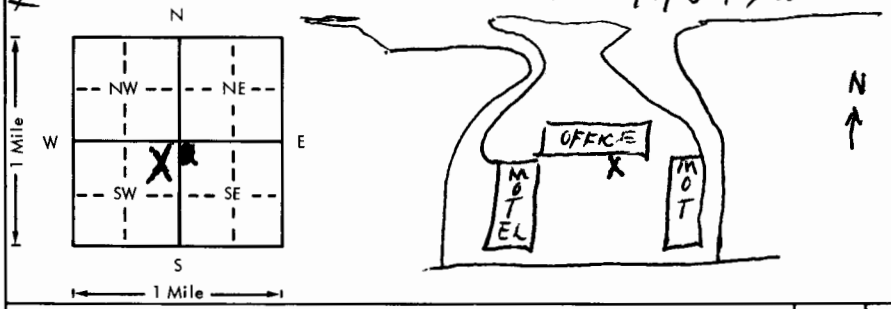

6. Bore hole dia. 8 in. Completion date 5/31/79
Well depth 40 ft.

7. ✓ Cable tool __ Rotary __ Driven __ Dug
__ Hollow rod __ Jetted __ Bored __ Reverse rotary

8. Use: __ Domestic __ Public supply __ Industry
__ Irrigation ✓ Air conditioning __ Stock
__ Lawn __ Oil field water __ Other

Casing: Material STEEL Height: Above or below
Threaded ___ Welded ✓ Surface 24" in.
RMP ✓ PVC ___ Weight [redacted] lbs./ft.
Dia. 5 in. to 40 ft. depth Wall Thickness: inches or
Dia. ___ in. to ___ ft. depth gage No. 200

5. Type and color of material	From	To
Top Soil	1	5
BROWN FILL SAND	5	15
GRY CLAY	15	20
FINE REDISH BROW SAND	20	24
SAND FINE GRAY-BLACK	24	26
SAND + GRAVEL	26	41

(Use a second sheet if needed)

10. Screen: Manufacturer's name SUNFLOWER
Type STEEL Dia. 5"
Slot/gauze ✓" Length 5'
Set between 36' ft. and [redacted] 40 ft.
BOTTOM ft. and ___ ft.
Gravel pack? 1/4" Size range of material ___

11. Static water level: mo./day/yr.
25 ft. below land surface Date 5/31/79

12. Pumping level below land surfaces:
25 ft. after 2 hrs. pumping 16 g.p.m.
25 ft. after 1 hrs. pumping 16 g.p.m.
Estimated maximum yield 40 g.p.m.

13. Water sample submitted: mo./day/yr.
__ Yes ✓ No Date ___

14. Well head completion:
✓ Pitless adapter 24 Inches above grade

15. Well grouted? ✓
With: ✓ Neat cement ___ Bentonite ___ Concrete
Depth: From [redacted] ft. to [redacted] ft. 21'

16. Nearest source of possible contamination:
ft. 1121 Direction S Type SEW.
Well disinfected upon completion? ✓ Yes ___ No

17. Pump: WAS [redacted] installed
Manufacturer's name MEYERS
Model number ___ HP 1/3 Volts 115
Length of drop pipe 38 ft. capacity 2 g.p.m.
Type:
__ Submersible __ Turbine
__ Jet __ Reciprocating
__ Centrifugal ✓ PISTON Other

T 11 R 16 (E) W Sec 17 1/4 1/4 1/4 NE NE SW

883 (from map)

18. Elevation: ~~867~~
Topography:
__ Hill
__ Slope
__ Upland
__ Valley

19. Remarks: A piston pump is A SMALL RECIPRACATING pump ABOUT 250-GALS AN hour

20. Water well contractor's certification:
This well was drilled under my jurisdiction and this report is true to the best of my knowledge and belief.
H. L. Pettit 333
Business name License No.
Address 905 N MICHIGAN
Signed H.L. PETTIT Date 6/4/79
Authorized representative

Forward the white, blue and pink copies to the Department of Health and Environment

Form WWC-5

BR<826 Z = 842