


MW-2

1 LOCATION OF WATER WELL: County: Shawnee	Fraction NE 1/4 NE 1/4 NE 1/4	Section Number 20	Township Number T 11 S	Range Number R 16 EW
---	---	-----------------------------	----------------------------------	--------------------------------

Distance and direction from nearest town or city street address of well if located within city?
101 NE Highway 24 Topeka, KS

2 WATER WELL OWNER: **Kerr Mcbee**
 RR#, St. Address, Box #: **P.O. Box 25861**
 City, State, ZIP Code: **Oklahoma City, OK 73125**
 Board of Agriculture, Division of Water Resources
 Application Number:

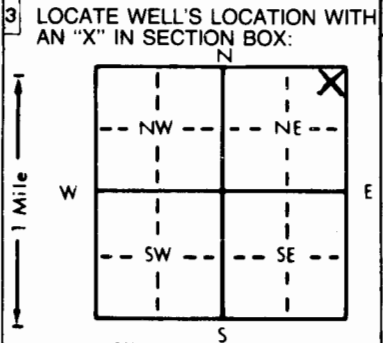

4 DEPTH OF COMPLETED WELL: **28.5** ft. ELEVATION:

Depth(s) Groundwater Encountered 1. ft. 2. ft. 3. ft.

WELL'S STATIC WATER LEVEL: **19.6** ft. below land surface measured on mo/day/yr **5/15/98**

Pump test data: Well water was ft. after hours pumping gpm

Est. Yield gpm: Well water was ft. after hours pumping gpm

Bore Hole Diameter: **8** in. to **30** in. to in. to in.

WELL WATER TO BE USED AS:

5 Public water supply	8 Air conditioning	11 Injection well
1 Domestic	3 Feedlot	6 Oil field water supply
2 Irrigation	4 Industrial	7 Lawn and garden only
		10 Monitoring well
		12 Other (Specify below)

Was a chemical/bacteriological sample submitted to Department? Yes..... No **X**; If yes, mo/day/yr sample was submitted

Water Well Disinfected? Yes No **X**

5 TYPE OF BLANK CASING USED:

1 Steel	3 RMP (SR)	6 Asbestos-Cement	9 Other (specify below)
2 PVC	4 ABS	7 Fiberglass	

Blank casing diameter: **2** in. to **13.5** ft. Dia. in. to ft. Dia. in. to ft.

Casing height above land surface: **0** in., weight **0.70** lbs./ft. Wall thickness or gauge No. **Sch 40**

CASING JOINTS: Glued Clamped
 Welded
 Threaded **X**

TYPE OF SCREEN OR PERFORATION MATERIAL:

1 Steel	3 Stainless steel	5 Fiberglass	8 RMP (SR)	10 Asbestos-cement
2 Brass	4 Galvanized steel	6 Concrete tile	9 ABS	11 Other (specify)
				12 None used (open hole)

SCREEN OR PERFORATION OPENINGS ARE:

1 Continuous slot	3 Mill slot	5 Gauzed wrapped	8 Saw cut	11 None (open hole)
2 Louvered shutter	4 Key punched	6 Wire wrapped	9 Drilled holes	
		7 Torch cut	10 Other (specify)	

SCREEN-PERFORATED INTERVALS: From **13.5** ft. to **28.5** ft., From ft. to ft.

GRAVEL PACK INTERVALS: From **11.5** ft. to **28.5** ft., From ft. to ft.

6 GROUT MATERIAL: **1 Neat cement** 2 Cement grout **3 Bentonite** 4 Other

Grout Intervals: From **1** ft. to **9** ft., From **9** ft. to **11.5** ft., From ft. to ft.

What is the nearest source of possible contamination:

1 Septic tank	4 Lateral lines	7 Pit privy	10 Livestock pens	14 Abandoned water well
2 Sewer lines	5 Cess pool	8 Sewage lagoon	11 Fuel storage	15 Oil well/Gas well
3 Watertight sewer lines	6 Seepage pit	9 Feedyard	12 Fertilizer storage	16 Other (specify below)
			13 Insecticide storage	

Direction from well? How many feet?

FROM	TO	LITHOLOGIC LOG	FROM	TO	PLUGGING INTERVALS
0	9	Dark brown clay, very dry			
9	13	Light brown silty clay, wet			
13	23	Brown silt w/some clay, dry			
23	25	Brown silt w/some clay, wet			
25	30	Dark gray clay w/silt, very wet			

7 CONTRACTOR'S OR LANDOWNER'S CERTIFICATION: This water well was **(1)** constructed, (2) reconstructed, or (3) plugged under my jurisdiction and was completed on (mo/day/year) **5/15/98** and this record is true to the best of my knowledge and belief. Kansas Water Well Contractor's License No. **102** This Water Well Record was completed on (mo/day/yr) **6/17/98** under the business name of **Layne Christensen Company** by (signature) **_____** **Nate Baldwin**

OFFICE USE ONLY