


| | | | | |
|---|---|-----------------------------|----------------------------------|--------------------------------|
| 1 LOCATION OF WATER WELL: County: Shawnee | Fraction NE 1/4 NE 1/4 NE 1/4 | Section Number 20 | Township Number T 11 S | Range Number R 16 EW |
|---|---|-----------------------------|----------------------------------|--------------------------------|

Distance and direction from nearest town or city street address of well if located within city?
101 NE Highway 24 Topeka, KS

2 WATER WELL OWNER: **Kerr Mabey**
 RR#, St. Address, Box #: **P.O. Box 25861**
 City, State, ZIP Code: **Oklahoma City, OK 73125**
 Board of Agriculture, Division of Water Resources
 Application Number:

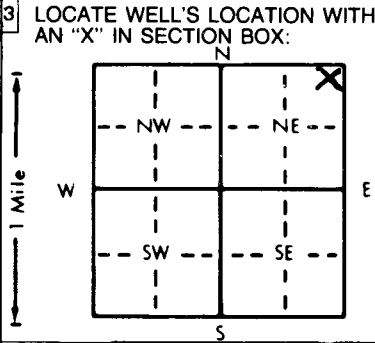

4 DEPTH OF COMPLETED WELL: **30** ft. ELEVATION: ft.
 Depth(s) Groundwater Encountered 1. ft. 2. ft. 3. ft.
 WELL'S STATIC WATER LEVEL **21** ft. below land surface measured on mo/day/yr **5/15/98**
 Pump test data: Well water was ft. after hours pumping gpm
 Est. Yield gpm: Well water was ft. after hours pumping gpm
 Bore Hole Diameter **8** in. to **30** ft., and in. to ft.
 WELL WATER TO BE USED AS:
 5 Public water supply 8 Air conditioning 11 Injection well
 1 Domestic 3 Feedlot 6 Oil field water supply 9 Dewatering 12 Other (Specify below)
 2 Irrigation 4 Industrial 7 Lawn and garden only **10** Monitoring well
 Was a chemical/bacteriological sample submitted to Department? Yes.....No **X**.....; If yes, mo/day/yr sample was submitted
 Water Well Disinfected? Yes No **X**

5 TYPE OF BLANK CASING USED:
 1 Steel 3 RMP (SR) 5 Wrought iron 8 Concrete tile CASING JOINTS: Glued Clamped
2 PVC 4 ABS 7 Fiberglass Threaded **X**
 Blank casing diameter **2** in. to **15** ft., Dia in. to ft., Dia in. to ft.
 Casing height above land surface **0** in., weight **0.70** lbs./ft. Wall thickness or gauge No. **Sch 40**
 TYPE OF SCREEN OR PERFORATION MATERIAL:
 1 Steel 3 Stainless steel 5 Fiberglass 8 RMP (SR) 10 Asbestos-cement
 2 Brass 4 Galvanized steel 6 Concrete tile 9 ABS 12 None used (open hole)
 SCREEN OR PERFORATION OPENINGS ARE:
 1 Continuous slot **3** Mill slot 5 Gauzed wrapped 8 Saw cut 11 None (open hole)
 2 Louvered shutter 4 Key punched 6 Wire wrapped 9 Drilled holes
 7 Torch cut 10 Other (specify)
 SCREEN-PERFORATED INTERVALS: From **15** ft. to **30** ft., From ft. to ft.
 GRAVEL PACK INTERVALS: From **13** ft. to **30** ft., From ft. to ft.

6 GROUT MATERIAL: **1** Neat cement 2 Cement grout **3** Bentonite 4 Other
 Grout Intervals: From **1** ft. to **10** ft., From **10** ft. to **13** ft., From ft. to ft.
 What is the nearest source of possible contamination:
 1 Septic tank 4 Lateral lines 7 Pit privy 10 Livestock pens 14 Abandoned water well
 2 Sewer lines 5 Cess pool 8 Sewage lagoon 11 Fuel storage 15 Oil well/Gas well
 3 Watertight sewer lines 6 Seepage pit 9 Feedyard 12 Fertilizer storage 16 Other (specify below)
 13 Insecticide storage
 Direction from well? How many feet?

| FROM | TO | LITHOLOGIC LOG | FROM | TO | PLUGGING INTERVALS |
|----------|-----------|--------------------------------------|------|----|--------------------|
| 0 | 1 | Concrete w/gravel sub-grade | | | |
| 1 | 8 | Dark gray silty clay | | | |
| 8 | 9 | Coarse silt w/very fine sand | | | |
| 9 | 30 | Fine grained sand w/some silt | | | |

7 CONTRACTOR'S OR LANDOWNER'S CERTIFICATION: This water well was **1** constructed, (2) reconstructed, or (3) plugged under my jurisdiction and was completed on (mo/day/year) **5/14/98** and this record is true to the best of my knowledge and belief. Kansas Water Well Contractor's License No. **102** This Water Well Record was completed on (mo/day/yr) **6/17/98** under the business name of **Layne Christensen Company** by (signature) *[Signature]* **Nate Baldwin**

OFFICE USE ONLY
T
R
EW
SEC
1/4
1/4
1/4