

1 LOCATION OF WATER WELL: County: SHAWNEE	Fraction SW 1/4 SE 1/4 NE 1/4	Section Number 20	Township Number T 11 S	Range Number R 16E EW
---	---	-----------------------------	----------------------------------	---------------------------------

Distance and direction from nearest town or city street address of well if located within city?


in Topeka @ 1926 north Jefferson

2 WATER WELL OWNER: **Charles Sackrider**
 RR#, St. Address, Box # : **1926 N. Jefferson**
 City, State, ZIP Code : **Topeka, KS 66608**

Board of Agriculture, Division of Water Resources
 Application Number:

3 LOCATE WELL'S LOCATION WITH AN "X" IN SECTION BOX:

4 DEPTH OF COMPLETED WELL: **47'** ft. ELEVATION:

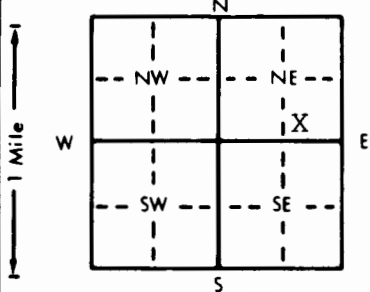

Depth(s) Groundwater Encountered 1. ft. 2. ft. 3. ft.

WELL'S STATIC WATER LEVEL **25'** ft. below land surface measured on mo/day/yr **2/23/98**

Pump test data: Well water was ft. after hours pumping gpm

Est. Yield **50** gpm: Well water was ft. after hours pumping gpm

Bore Hole Diameter **12"** in. to ft., and in. to ft.

WELL WATER TO BE USED AS:

5 Public water supply	8 Air conditioning	11 Injection well
1 Domestic	3 Feedlot	6 Oil field water supply
2 Irrigation	4 Industrial	7 Lawn and garden only
		9 Dewatering
		12 Other (Specify below)

Was a chemical/bacteriological sample submitted to Department? Yes.....No.....; If yes, mo/day/yr sample was submitted

Water Well Disinfected? Yes No

5 TYPE OF BLANK CASING USED:

1 Steel	3 RMP (SR)	5 Wrought iron	8 Concrete tile	CASING JOINTS: Glued	Clamped
2 PVC	4 ABS	6 Asbestos-Cement	9 Other (specify below)	Welded	
		7 Fiberglass		Threaded	

Blank casing diameter **5"** in. to **0-37** ft., Dia. in. to ft., Dia. in. to ft.

Casing height above land surface **24"** in., weight **2.82** lbs./ft. Wall thickness or gauge No. **258**

TYPE OF SCREEN OR PERFORATION MATERIAL:

1 Steel	3 Stainless steel	5 Fiberglass	7 PVC	10 Asbestos-cement
2 Brass	4 Galvanized steel	6 Concrete tile	8 RMP (SR)	11 Other (specify)
			9 ABS	12 None used (open hole)

SCREEN OR PERFORATION OPENINGS ARE:

1 Continuous slot	3 Mill slot	5 Gauzed wrapped	8 Saw cut	11 None (open hole)
2 Louvered shutter	4 Key punched	6 Wire wrapped	9 Drilled holes	
		7 Torch cut	10 Other (specify)	

SCREEN-PERFORATED INTERVALS: From **37** ft. to **47** ft., From ft. to ft.

GRAVEL PACK INTERVALS: From **24** ft. to **47** ft., From ft. to ft.

6 GROUT MATERIAL: 1 Neat cement 2 Cement grout 3 Bentonite 4 Other

Grout Intervals: From **4** ft. to **24** ft., From ft. to ft.

What is the nearest source of possible contamination:

1 Septic tank	4 Lateral lines	7 Pit privy	10 Livestock pens	14 Abandoned water well
2 Sewer lines	5 Cess pool	8 Sewage lagoon	11 Fuel storage	15 Oil well/Gas well
3 Watertight sewer lines	6 Seepage pit	9 Feedyard	12 Fertilizer storage	16 Other (specify below)
			13 Insecticide storage	

Direction from well? **west** How many feet? **50'**

FROM	TO	LITHOLOGIC LOG	FROM	TO	PLUGGING INTERVALS
0	10	Fine Silt-Sandy			
10	19	Fine Sand-Brown			
19	22	Fine Sand-Coarse Sand-Brown			
22	26	Fine Sand-Coarse Sand-Med Gravel-Brown			
26	36	Fine Sand-Brown			
36	38	Clay-Brown			
38	41	FS-Cs-Med Gravel-Brown			
41	47	FS-CS-Med Pea Brown-Grey			

7 CONTRACTOR'S OR LANDOWNER'S CERTIFICATION: This water well was (1) constructed, (2) reconstructed, or (3) plugged under my jurisdiction and was completed on (mo/day/year) **2/23/98** and this record is true to the best of my knowledge and belief. Kansas Water Well Contractor's License No. **182** This Water Well Record was completed on (mo/day/yr) **3-4-98** under the business name of **STRADER DRILLING CO., INC.** by (signature) *Dale Askren*

OFFICE USE ONLY T R EW SEC 1/4 1/4