

CORRECTION(S) TO WATER WELL RECORD (WWC-5)

(to rectify lacking or incorrect information)

County: Shawnee

Location listed as:

Section-Township-Range: None Given

Fraction ($\frac{1}{4}$ $\frac{1}{4}$ $\frac{1}{4}$): _____

Location changed to:

36-115-16E

NE NE SE

Other changes: Initial statements: _____

Changed to: _____

Comments: _____


verification method: Well owners address, city street map,
and mapping tool on KGS website.

initials: DRL date: 11/13/2006

1 LOCATION OF WATER WELL: Fraction $\frac{1}{4}$ $\frac{1}{4}$ $\frac{1}{4}$ Section Number Township Number Range Number E/W
 County: Shawnee

Distance and direction from nearest town or city street address of well if located within city?

2 WATER WELL OWNER: Cheryl Hetrick Global Positioning Systems (decimal degrees, min. of 4 digits)
 RR#, St. Address, Box #: 211 Arapahoe St Latitude: _____
 City, State ZIP Code: Tecumseh KS 66542 Longitude: _____
 Elevation: _____
 Datum: _____
 Data Collection Method: _____

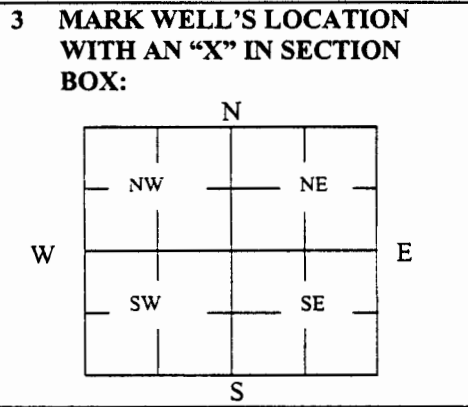

4 DEPTH OF WELL 29 ft.
 WELL'S STATIC WATER LEVEL 18 ft.
 WELL WAS USED AS:
 1 Domestic 5 Public Water Supply 9 Dewatering
 2 Irrigation 6 Oil Field Water Supply 10 Monitoring
 3 Feedlot 7 Domestic (Lawn & Garden) 11 Injection Well
 4 Industrial 8 Air Conditioning 12 Other Abandoned
 Was a chemical/bacteriological sample submitted to Department? Yes ___ No

5 TYPE OF BLANK CASING USED:
 1 Steel 3 RMP (SR) 5 Wrought 7 Fiberglass 9 Other (Specify below)
 2 PVC 4 ABS 6 Asbestos-Cement 8 Concrete Tile Hard Dug Rock lined
 Blank casing diameter _____ in. Was casing pulled? Yes ___ No If yes, how much _____
 Casing height above or below land surface _____ in.

6 GROUT PLUG MATERIAL: 1 Neat cement 2 Cement grout 3 Bentonite 4 Other _____
 Grout Plug Intervals: From 5' ft. to 4'6" ft., From _____ ft. to _____ ft., From _____ to _____ ft.

What is the nearest source of possible contamination:
 1 Septic tank 6 Seepage pit 11 Fuel Storage 16 Other (specify below) _____
 2 Sewer lines 7 Pit privy 12 Fertilizer storage _____
 3 Watertight sewer lines 8 Sewage lagoon 13 Insecticide storage _____
 4 Lateral lines 9 Feedyard 14 Abandoned water well Direction from well? East
 5 Cess pool 10 Livestock pens 15 Oil well/Gas well How many feet? 50 ft

FROM	TO	PLUGGING MATERIALS	FROM	TO	PLUGGING MATERIALS
<u>29</u>	<u>18</u>	<u>sand</u>			
<u>18</u>	<u>5</u>	<u>clay</u>			
<u>5</u>	<u>4'6"</u>	<u>Bentonite</u>			
<u>4'6"</u>	<u>0</u>	<u>Topsoil</u>			

7 CONTRACTOR'S OR LANDOWNER'S CERTIFICATION: This water well was plugged under my jurisdiction and was completed on (mo/day/year) 10-25-06 and this record is true to the best of my knowledge and belief. Kansas Water Well Contractor's License No. _____. This Water Well Record was completed on (mo/day/year) 10-25-06 under the business name of X King Unlimited by (signature) X J W Y

INSTRUCTIONS: Use typewriter or ballpoint pen. Please press firmly and print clearly. Please fill in blanks, underline or circle the correct answers. Send top three copies to Kansas Department of Health and Environment, Bureau of Water, Geology Section, 1000 SW Jackson St., Ste. 420, Topeka, Kansas 66612-1367. Telephone: 785/296-5522. Send one to Water Well Owner and retain one for your records. Visit us at <http://www.kdheks.gov/geo/waterwells>.