

**WATER WELL PLUGGING RECORD Form WWC-5P**


Amoco 5289  
KSA 82a-1212 ID NO. MW-9

**1 LOCATION OF WATER WELL:**  
 County: Shawnee Fraction NW 1/4 SE 1/4 SE 1/4 Section Number 18 Township Number 11 Range Number 16 D/W

Distance and direction from nearest town or city street address of well if located within city?  
635 Hwy 24 Topeka KS 66608

**2 WATER WELL OWNER:** BP Amoco  
 RR#, St. Address, Box #: 635 HWY 24  
 City, State ZIP Code: Topeka KS 66608

**Global Positioning Systems** (decimal degrees, min. of 4 digits)  
 Latitude: \_\_\_\_\_  
 Longitude: \_\_\_\_\_  
 Elevation: 879.22  
 Datum: 879.49  
 Data Collection Method: Legal Survey

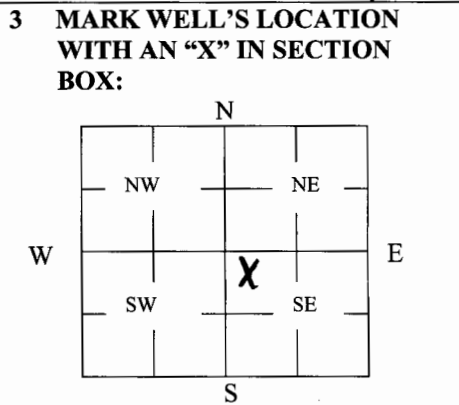

**4 DEPTH OF WELL** 19.282 ft.  
 WELL'S STATIC WATER LEVEL Dry ft.  
 WELL WAS USED AS:  
 1 Domestic                      5 Public Water Supply                      9 Dewatering  
 2 Irrigation                      6 Oil Field Water Supply                       Monitoring  
 3 Feedlot                          7 Domestic (Lawn & Garden)                      11 Injection Well  
 4 Industrial                      8 Air Conditioning                          12 Other \_\_\_\_\_

Was a chemical/bacteriological sample submitted to Department? Yes \_\_\_\_\_ No

**5 TYPE OF BLANK CASING USED:**  
 1 Steel      3 RMP (SR)      5 Wrought      7 Fiberglass      9 Other (Specify below)  
 PVC      4 ABS      6 Asbestos-Cement      8 Concrete Tile

Blank casing diameter 2 in. Was casing pulled? Yes  No \_\_\_\_\_ If yes, how much 20'  
 Casing height above or below land surface \_\_\_\_\_ in.

**6 GROUT PLUG MATERIAL:**      1 Neat cement      2 Cement grout       Bentonite      4 Other \_\_\_\_\_

Grout Plug Intervals: From 0 ft. to 20 ft., From \_\_\_\_\_ ft. to \_\_\_\_\_ ft., From \_\_\_\_\_ to \_\_\_\_\_ ft.

What is the nearest source of possible contamination:  
 1 Septic tank      6 Seepage pit      11 Fuel Storage       Other (specify below)  
 2 Sewer lines      7 Pit privy      12 Fertilizer storage      USTs  
 3 Watertight sewer lines      8 Sewage lagoon      13 Insecticide storage  
 4 Lateral lines      9 Feedyard      14 Abandoned water well      Direction from well? N  
 5 Cess pool      10 Livestock pens      15 Oil well/Gas well      How many feet? 200'

| FROM     | TO        | PLUGGING MATERIALS | FROM | TO | PLUGGING MATERIALS |
|----------|-----------|--------------------|------|----|--------------------|
| <u>0</u> | <u>20</u> | <u>Bentonite</u>   |      |    |                    |
|          |           |                    |      |    |                    |
|          |           |                    |      |    |                    |
|          |           |                    |      |    |                    |
|          |           |                    |      |    |                    |

**7 CONTRACTOR'S OR LANDOWNER'S CERTIFICATION:** This water well was plugged under my jurisdiction and was completed on (mo/day/year) 11/20/06 and this record is true to the best of my knowledge and belief. Kansas Water Well Contractor's License No. 709. This Water Well Record was completed on (mo/day/year) 11/2/07 under the business name of maxs by (signature) David Mungell

**INSTRUCTIONS:** Use typewriter or ballpoint pen. Please press firmly and print clearly. Please fill in blanks, underline or circle the correct answers. Send top three copies to Kansas Department of Health and Environment, Bureau of Water, Geology Section, 1000 SW Jackson St., Ste. 420, Topeka, Kansas 66612-1367. Telephone: 785/296-5522. Send one to Water Well Owner and retain one for your records. Visit us at <http://www.kdheks.gov/geo/waterwells>.