

WATER WELL PLUGGING RECORD Form WWC-5P

Amoco 5289
KSA 82a-1212 ID NO.

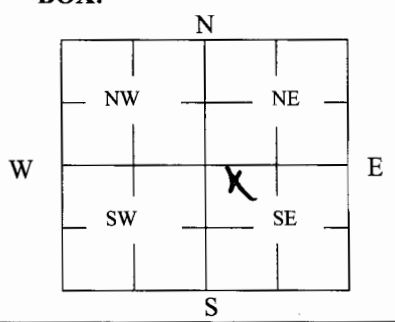
MW-14

1 LOCATION OF WATER WELL: County: <u>Shawnee</u>	Fraction <u>NW 1/4 SE 1/4 SE 1/4</u>	Section Number <u>18</u>	Township Number <u>11</u>	Range Number <u>16</u> <small>EW</small>
------------------------------------------------------------	-----------------------------------------	-----------------------------	------------------------------	---------------------------------------------

Distance and direction from nearest town or city street address of well if located within city?

635 Hwy 24 Topeka KS 66608

2 WATER WELL OWNER: <u>BP Amoco</u> RR#, St. Address, Box #: <u>635 Hwy 24</u> City, State ZIP Code: <u>Topeka KS 66608</u>	Global Positioning Systems (decimal degrees, min. of 4 digits) Latitude: _____ Longitude: _____ Elevation: <u>882.43</u> Datum: <u>882.72</u> Data Collection Method: _____
---	---

3 MARK WELL'S LOCATION WITH AN "X" IN SECTION BOX: 	4 DEPTH OF WELL <u>28.90</u> ft. WELL'S STATIC WATER LEVEL <u>26.48</u> ft. WELL WAS USED AS: 1 Domestic 5 Public Water Supply 9 Dewatering 2 Irrigation 6 Oil Field Water Supply 10 Monitoring 3 Feedlot 7 Domestic (Lawn & Garden) 11 Injection Well 4 Industrial 8 Air Conditioning 12 Other _____ Was a chemical/bacteriological sample submitted to Department? Yes _____ No <u>X</u>
---	---

5 TYPE OF BLANK CASING USED:

1 Steel	3 RMP (SR)	5 Wrought	7 Fiberglass	9 Other (Specify below)
2 PVC	4 ABS	6 Asbestos-Cement	8 Concrete Tile	

Blank casing diameter 2 in. Was casing pulled? Yes X No _____ If yes, how much 29'
Casing height above or below land surface _____ in.

6 GROUT PLUG MATERIAL: 1 Neat cement 2 Cement grout 3 Bentonite 4 Other _____

Grout Plug Intervals: From 0 ft. to 29 ft., From _____ ft. to _____ ft., From _____ to _____ ft.

What is the nearest source of possible contamination:

1 Septic tank	6 Seepage pit	11 Fuel Storage	16 Other (specify below)
2 Sewer lines	7 Pit privy	12 Fertilizer storage	<u>UST's</u>
3 Watertight sewer lines	8 Sewage lagoon	13 Insecticide storage	
4 Lateral lines	9 Feedyard	14 Abandoned water well	Direction from well? <u>NW</u>
5 Cess pool	10 Livestock pens	15 Oil well/Gas well	How many feet? <u>150'</u>

FROM	TO	PLUGGING MATERIALS	FROM	TO	PLUGGING MATERIALS
<u>0</u>	<u>29</u>	<u>Bentonite</u>			

7 CONTRACTOR'S OR LANDOWNER'S CERTIFICATION: This water well was plugged under my jurisdiction and was completed on (mo/day/year) 11/20/06 and this record is true to the best of my knowledge and belief. Kansas Water Well Contractor's License No. 709. This Water Well Record was completed on (mo/day/year) 11/20/07 under the business name of Max's by (signature) Dennis Sample

INSTRUCTIONS: Use typewriter or ballpoint pen. Please press firmly and print clearly. Please fill in blanks, underline or circle the correct answers. Send top three copies to Kansas Department of Health and Environment, Bureau of Water, Geology Section, 1000 SW Jackson St., Ste. 420, Topeka, Kansas 66612-1367. Telephone: 785/296-5522. Send one to Water Well Owner and retain one for your records. Visit us at <http://www.kdheks.gov/geo/waterwells>.