


WATER WELL RECORD Form WWC-5 KSA 82a-1212

1 LOCATION OF WATER WELL: Fraction NW 1/4 NW 1/4 NW 1/4 Section Number 32 Township Number T 11 S Range Number R 16 E/W

Distance and direction from nearest town or city street address of well if located within city? 134 SE Quincy, Topeka

2 WATER WELL OWNER: Scotch Industries, Inc. RR#, St. Address, Box #: 1029 New Hampshire St. City, State, ZIP Code: Lawrence, KS 66044 Board of Agriculture, Division of Water Resources Application Number:

3 LOCATE WELL'S LOCATION WITH AN "X" IN SECTION BOX:

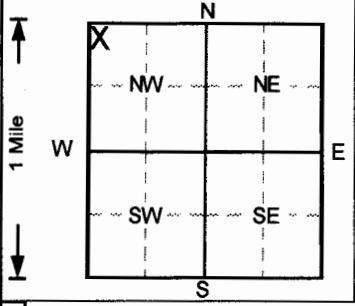

4 DEPTH OF COMPLETED WELL: 45 ft. ELEVATION: ... Depth(s) Groundwater Encountered: 1. 15 ft. 2. ... ft. 3. ... ft. WELL'S STATIC WATER LEVEL: ... ft. below land surface ... Pump test data: Well water was NA ft. after ... hours pumping ... gpm Est Yield NA gpm: Well water was ... ft. after ... hours pumping ... gpm Bore Hole Diameter: 8 in. to 45 in. ... ft. and ... in. to ... ft. WELL WATER TO BE USED AS: 5 Public water supply 8 Air conditioning 11 Injection well 1 Domestic 3 Feedlot 6 Oil field water supply 9 Dewatering 12 Other (Specify below) 2 Irrigation 4 Industrial 7 Lawn and garden only 10 Monitoring well Was a chemical/bacteriological sample submitted to Department? Yes No [checked] ; If yes, mo/day/yr sample was submitted Water Well Disinfected? Yes No [checked]

5 TYPE OF BLANK CASING USED: 1 Steel 2 PVC [checked] 3 RMP (SR) 4 ABS Blank casing diameter 2 in. to 35 ft. Dia in. to ... ft. Dia in. to ... ft. Casing height above land surface 0 in., weight ... lbs./ft. Wall thickness or gauge No. Sch. 40 TYPE OF SCREEN OR PERFORATION MATERIAL: 1 Steel 2 Brass 3 Stainless steel 4 Galvanized steel 5 Fiberglass 6 Concrete tile 7 PVC [checked] 8 RMP (SR) 9 ABS 10 Asbestos-cement 11 Other (specify) 12 None used (open hole) SCREEN OR PERFORATION OPENINGS ARE: 1 Continuous slot 2 Louvered shutter 3 Mill slot [checked] 4 Key punched 5 Gauzed wrapped 6 Wire wrapped 7 Torch cut 8 Saw cut 9 Drilled holes 10 Other (specify) 11 None (open hole) SCREEN-PERFORATED INTERVALS: From 35 ft. to 45 ft. From ... ft. to ... ft. From ... ft. to ... ft. GRAVEL PACK INTERVALS: From 29 ft. to 45 ft. From ... ft. to ... ft. From ... ft. to ... ft.

6 GROUT MATERIAL: 1 Neat cement 2 Cement grout 3 Bentonite [checked] 4 Other Concrete [checked] Grout Intervals: From 0 ft. to 1 ft. From 1 ft. to 29 ft. From ... ft. to ... ft. What is the nearest source of possible contamination: 1 Septic tank 2 Sewer lines 3 Watertight sewer lines 4 Lateral lines 5 Cess pool 6 Seepage pit 7 Pit privy 8 Sewage lagoon 9 Feedyard 10 Livestock pens 11 Fuel storage 12 Fertilizer storage 13 Insecticide storage 14 Abandoned water well 15 Oil well/Gas well 16 Other (specify below)

Direction from well? How many feet? LITHOLOGIC LOG FROM TO CLAY BACKFILL, SILTY 0 8 SAND BACKFILL, M GRAINED 8 37 SAND, F-M GRAINED 37 45 PLUGGING INTERVALS MW1SR, Flushmount

7 CONTRACTOR'S OR LANDOWNER'S CERTIFICATION: This water well was (1) constructed, (2) reconstructed, or (3) plugged under my jurisdiction and was completed on (mo/day/year) 6/24/2010 and this record is true to the best of my knowledge and belief. Kansas Water Well Contractor's License No. 527. This Water Well Record was completed on (mo/day/yr) 7/22/2010 under the business name of GeoCore, Inc. by (signature) [Signature]