


1	LOCATION OF WATER WELL:	Fraction	Section Number	Township Number	Range Number
	County: Shawnee	NW 1/4 NW 1/4 NW 1/4	32	T 11 S	R 16 (EW)

Distance and direction from nearest town or city street address of well if located within city?

134 SE Quincy, Topeka

2	WATER WELL OWNER: Scotch Industries, Inc.	Board of Agriculture, Division of Water Resources
	RR#, St. Address, Box #: 1029 New Hampshire St.	Application Number:
	City, State, ZIP Code: Lawrence, KS 66044	

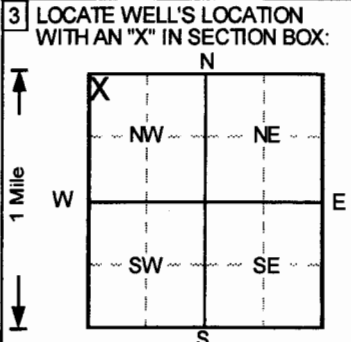

4 DEPTH OF COMPLETED WELL **32** ft ELEVATION:

Depth(s) Groundwater Encountered 1. **15** ft 2. ft 3. ft

WELL'S STATIC WATER LEVEL

Pump test data: Well water was **NA** ft after

Est. Yield **NA** gpm: Well water was ft after

Bore Hole Diameter **11** in. to **32** ft, and

WELL WATER TO BE USED AS: 5 Public water supply 8 Air conditioning 11 Injection well

1 Domestic 3 Feedlot 6 Oil field water supply 9 Dewatering **12** Other (Specify below) **Soil vapor extractio.**

2 Irrigation 4 Industrial 7 Lawn and garden only 10 Monitoring well

Was a chemical/bacteriological sample submitted to Department? Yes.....No ; If yes, mo/day/yr sample was submitted

Water Well Disinfected? Yes No

5 TYPE OF BLANK CASING USED:

1 Steel 3 RMP (SR) 5 Wrought iron 8 Concrete tile CASING JOINTS: Glued Clamped

2 PVC 4 ABS 6 Asbestos-Cement 9 Other (specify below) Welded

Blank casing diameter **4** in. to **12** ft, Dia in. to ft, Dia in. to ft

Casing height above land surface **0** in., weight

TYPE OF SCREEN OR PERFORATION MATERIAL **7** PVC 10 Asbestos-cement

1 Steel 3 Stainless steel 5 Fiberglass **8** RMP (SR) 11 Other (specify)

2 Brass 4 Galvanized steel 6 Concrete tile 9 ABS 12 None used (open hole)

SCREEN OR PERFORATION OPENINGS ARE:

1 Continuous slot **3** Mill slot 5 Gauzed wrapped 8 Saw cut 11 None (open hole)

2 Louvered shutter 4 Key punched 6 Wire wrapped 9 Drilled holes

3 Torch cut 10 Other (specify)

SCREEN-PERFORATED INTERVALS: From **12** ft to **32** ft, From ft to ft

GRAVEL PACK INTERVALS: From **9** ft to **32** ft, From ft to ft

6 GROUT MATERIAL: 1 Neat cement **2** Cement grout **3** Bentonite 4 Other

Grout Intervals: From **1** ft to **3** ft, From **3** ft to **9** ft, From ft to ft

What is the nearest source of possible contamination:

1 Septic tank 4 Lateral lines 7 Pit privy 10 Livestock pens 14 Abandoned water well

2 Sewer lines 5 Cess pool 8 Sewage lagoon 11 Fuel storage 15 Oil well/Gas well

3 Watertight sewer lines 6 Seepage pit 9 Feedyard 12 Fertilizer storage 16 Other (specify below)

13 Insecticide storage

Direction from well? How many feet?

FROM	TO	LITHOLOGIC LOG	FROM	TO	PLUGGING INTERVALS
0	8	Clay backfill, silty,			
8	32	Sand backfill, med.,			

7 CONTRACTOR'S OR LANDOWNER'S CERTIFICATION: This water well was **(1)** constructed, (2) reconstructed, or (3) plugged under my jurisdiction and was completed on (mo/day/year) **6/25/2010** and this record is true to the best of my knowledge and belief.

Kansas Water Well Contractor's License No. **527** This Water Well Record was completed on (mo/day/yr) **7/22/2010** under the business name of **GeoCore, Inc.** by (signature) *John Bell*

INSTRUCTIONS: Use typewriter or ball point pen. PLEASE PRESS FIRMLY and PRINT clearly. Please fill in blanks, underline or circle the correct answers. Send top three copies to Kansas Department of Health and Environment, Bureau of Water, Topeka, Kansas 66620-0001. Telephone: 913-296-5545. Send one to WATER WELL OWNER and retain one for your records.