

WATER WELL RECORD

Form WWC-5


Division of Water Resources App. No.

1 LOCATION OF WATER WELL: County: Shawnee	Fraction NE ¼ NE ¼ SE ¼ NW ¼	Section Number 31	Township No. T 11 S	Range Number R 16 <input checked="" type="checkbox"/> E <input type="checkbox"/> W
---	---------------------------------	----------------------	------------------------	---

Street/Rural Address of Well Location; if unknown, distance & direction from nearest town or intersection: If at owner's address, check here .
Former Valero Station #4172
506 SW Topeka Blvd, Topeka, KS 66603

Global Positioning System (GPS) information:
Latitude: .39.05458..... (in decimal degrees)
Longitude: 95.67034..... (in decimal degrees)
Elevation: TOC 930.99.....
Datum: WGS 84, NAD 83, NAD 27
Collection Method:
 GPS unit (Make/Model:)
 Digital Map/Photo, Topographic Map, Land Survey
Est. Accuracy: <3 m, 3-5 m, 5-15 m, >15 m

2 WATER WELL OWNER: MRP Properties, Inc.
RR#, Street Address, Box #: 5590 Havana St. Unit B
City, State, ZIP Code : Denver, CO 80239

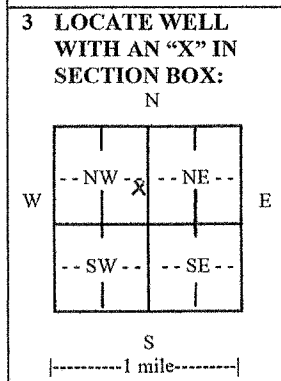

4 DEPTH OF COMPLETED WELL 19.50..... ft.
Depth(s) Groundwater Encountered (1) 18.60..... ft. (2) N/A..... ft. (3) N/A..... ft.
WELL'S STATIC WATER LEVEL 18.60..... ft. below land surface measured on mo/day/yr. 7-3-2014.....
Pump test data: Well water was N/A..... ft. after N/A..... hours pumping N/A..... gpm
EST. YIELD N/A..... gpm. Well water was N/A..... ft. after N/A..... hours pumping N/A..... gpm
Bore Hole Diameter 8.25..... in. to 19.50..... ft., and N/A..... in. to N/A..... ft.
WELL WATER TO BE USED AS: Public water supply Geothermal Injection well
 Domestic Feedlot Oil field water supply Dewatering Other (Specify below)
 Irrigation Industrial Domestic-lawn & garden Monitoring well MW-10
Was a chemical/bacteriological sample submitted to Department? Yes No
If yes, mo/day/yr sample was submitted N/A.....
Water well disinfected? Yes No

5 TYPE OF CASING USED: Steel PVC Other.....
CASING JOINTS: Glued Clamped Welded Threaded
Casing diameter 2..... in. to 9.5..... ft., Diameter N/A..... in. to N/A..... ft., Diameter N/A..... in. to N/A..... ft.
Casing height above land surface 0..... in., Weight N/A..... lbs./ft., Wall thickness or gauge No. Schedule 40
TYPE OF SCREEN OR PERFORATION MATERIAL:
 Steel Stainless Steel PVC Other (Specify).....
 Brass Galvanized Steel None used (open hole)
SCREEN OR PERFORATION OPENINGS ARE:
 Continuous slot Mill slot Gauze wrapped Torch cut Drilled holes None (open hole)
 Louvered shutter Key punched Wire wrapped Saw cut Other (specify).....
SCREEN-PERFORATED INTERVALS: From 9.5..... ft. to 19.5..... ft., From N/A..... ft. to N/A..... ft.
From N/A..... ft. to N/A..... ft., From N/A..... ft. to N/A..... ft.
GRAVEL PACK INTERVALS: From 7.5..... ft. to 19.5..... ft., From N/A..... ft. to N/A..... ft.
From N/A..... ft. to N/A..... ft., From N/A..... ft. to N/A..... ft.

6 GROUT MATERIAL: Neat cement Cement grout Bentonite Other Concrete 0-2-feet
Grout Intervals: From 2..... ft. to 7.5..... ft., From N/A..... ft. to N/A..... ft., From N/A..... ft. to N/A..... ft.
What is the nearest source of possible contamination:
 Septic tank Lateral lines Pit privy Livestock pens Insecticide storage Other (specify below)
 Sewer lines Cesspool Sewage lagoon Fuel storage Abandoned water well
 Watertight sewer lines Seepage pit Feedyard Fertilizer storage Oil well/gas well
Direction from well Southeast..... Distance from well 200-feet.....

FROM	TO	LITHOLOGIC LOG	FROM	TO	LITHO. LOG (cont.) or PLUGGING INTERVALS
0	5	Top soil organic rich black medium moisture			alluvial sands orange tan/gray at 16-feet
5	11	Silty clay loam gray stiff moist /dry	19.5		Auger refusal
		clay loam red oxidizing traces of fine sand moist stiff at 8-feet			
11	19.5	gradual change to sand with clay fine grained rounded increase in moisture			
		Sand fine grain moist to saturated			

7 CONTRACTOR'S OR LANDOWNER'S CERTIFICATION: This water well was constructed, reconstructed, or plugged under my jurisdiction and was completed on (mo/day/year) 7-3-2014..... and this record is true to the best of my knowledge and belief. Kansas Water Well Contractor's License No. 759..... This Water Well Record was completed on (mo/day/year) 7-16-2014..... under the business name of RAZEK Environmental, LLC..... by (signature) *Amber G. Burt*

INSTRUCTIONS: Use typewriter or ball point pen. PLEASE PRESS FIRMLY and PRINT clearly. Please fill in blanks and check the correct answers. Send one copy to Kansas Department of Health and Environment, Bureau of Water, Geology Section, 1000 SW Jackson St., Suite 420, Topeka, Kansas 66612-1367. Telephone 785-296-5524. Send one copy to WATER WELL OWNER and retain one for your records. Include fee of \$5.00 for each constructed well. Visit us at <http://www.kdheks.gov/waterwell/index.html>