

County: Shawnee Fraction NW NE NE Sec. 20 T 11 S R 16 @W

**CORRECTION(S) TO WATER WELL COMPLETION RECORD (WWC-5)**

(to rectify lacking or incorrect information)

Owner: Kerr McGee Retining Corp.

Location was listed as:

Section-Township-Range: 35-24s-18w

Fraction (1/4 1/4 1/4): NW NE NE

Location changed to:

20-11s-16w

NW NE NE

Other changes: Initial statements: Location seems to link to a project in Allen County,  
but other info matches a project in Shawnee Co.

Changed to: \_\_\_\_\_

Comments: MW 4

Verification method: \_\_\_\_\_

initials: DAM date: Jan 25, 2015

Submitted by: Kansas Geological Survey, Data Resources Library, 1930 Constant Ave., Lawrence, KS 66047-3726


to: Kansas Dept of Health & Environment, Bureau of Water, 1000 SW Jackson, Suite 420, Topeka, KS 66612-1367.

1 LOCATION OF WATER WELL: Fraction NW 1/4 NE 1/4 NE 1/4 Section Number 35 Township Number T 24 R 18 Range Number

Distance and direction from nearest town or city street address of well if located within city? 101 NE HWY 24 Topeka KS

2 WATER WELL OWNER: Kern McGee Refining Corp PO Box 3367 Houston TX 77253 Board of Agriculture, Division of Water Resources Application Number:

3 LOCATE WELL'S LOCATION WITH AN "X" IN SECTION BOX:

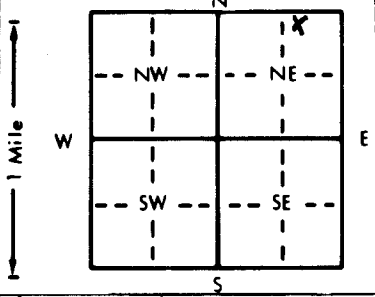

4 DEPTH OF COMPLETED WELL: 29 ft. ELEVATION: 98.94 ft. WELL'S STATIC WATER LEVEL: 14.34 ft. below land surface measured on 9-21-93

5 TYPE OF BLANK CASING USED: 1 Steel, 2 Brass, 3 RMP (SR), 4 ABS, 5 Wrought iron, 6 Asbestos-Cement, 7 Fiberglass, 8 Concrete tile, 9 Other (specify below), 10 PVC, 11 Other (specify below), 12 None used (open hole)

6 GROUT MATERIAL: 1 Neat cement, 2 Cement grout, 3 Bentonite, 4 Other. Grout intervals: From 0.0 ft. to 11.0 ft.

Table with columns: FROM, TO, LITHOLOGIC LOG, FROM, TO, PLUGGING INTERVALS. Rows contain data for concrete & sand, silt & dk gr, and silt & sand gr.

7 CONTRACTOR'S OR LANDOWNER'S CERTIFICATION: This water well was constructed, (2) reconstructed, or (3) plugged under my jurisdiction and was completed on 9-10-93 and this record is true to the best of my knowledge and belief. Kansas Water Well Contractor's License No. 416 This Water Well Record was completed on 1-7-94 under the business name of Terracon Consultants Inc by signature Richard D. Murphy