


1 LOCATION OF WATER WELL: Fraction **NW 1/4 SW 1/4 SE 1/4** Section Number **17** Township Number **T 11 S** Range Number **R 16 E/W**
 County: **Shawnee**

Distance and direction from nearest town or city street address of well if located within city?
101 NE US 24, Topeka

2 WATER WELL OWNER: **Greenfield Environmental Multistate Trust LLC**
 RF#: St. Address, Box #: **1920 232nd Place SE** Board of Agriculture, Division of Water Resources
 City, State, ZIP Code: **Bothell, WA 98021** Application Number:

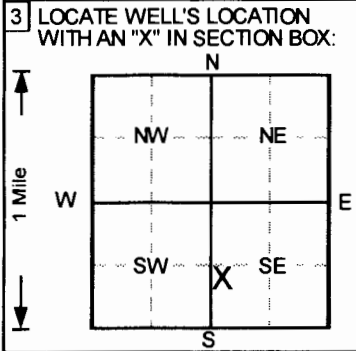

4 DEPTH OF COMPLETED WELL: **25** ft. ELEVATION:
 Depth(s) Groundwater Encountered 1. **10** ft. 2. ft. 3. ft.
 WELL'S STATIC WATER LEVEL: ft. below land surface measured on mo/day/yr
 Pump test data: Well water was **NA** ft. after hours pumping gpm
 Est. Yield **NA** gpm: Well water was ft. after hours pumping gpm
 Bore Hole Diameter **10** in. to **30** ft. and in. to ft.
 WELL WATER TO BE USED AS: 5 Public water supply 8 Air conditioning 11 Injection well
 1 Domestic 3 Feedlot 6 Oil field water supply 9 Dewatering **12 Other (Specify below)**
 2 Irrigation 4 Industrial 7 Lawn and garden only 10 Monitoring well **Soil vapor extract.**
 Was a chemical/bacteriological sample submitted to Department? Yes.....No ; If yes, mo/day/yr sample was submitted
 Water Well Disinfected? Yes No

5 TYPE OF BLANK CASING USED: 5 Wrought iron 8 Concrete tile CASING JOINTS: Glued Clamped
 1 Steel 3 RMP (SR) 6 Asbestos-Cement 9 Other (specify below) Welded
2 PVC 4 ABS 7 Fiberglass Threaded
 Blank casing diameter **4** in. to **10** ft. Dia in. to ft. Dia in. to ft.
 Casing height above land surface in., weight lbs./ft. Wall thickness or gauge No. **Sch. 40**
 TYPE OF SCREEN OR PERFORATION MATERIAL **7 PVC** 10 Asbestos-cement
 1 Steel 3 Stainless steel 5 Fiberglass 8 RMP (SR) 11 Other (specify)
 2 Brass 4 Galvanized steel 6 Concrete tile 9 ABS 12 None used (open hole)
 SCREEN OR PERFORATION OPENINGS ARE: 5 Gauzed wrapped 8 Saw cut 11 None (open hole)
 1 Continuous slot **3 Mill slot** 6 Wire wrapped 9 Drilled holes
 2 Louvered shutter 4 Key punched 7 Torch cut 10 Other (specify)
 SCREEN-PERFORATED INTERVALS: From **10** ft. to **25** ft. From ft. to ft.
 From ft. to ft. From ft. to ft.
 GRAVEL PACK INTERVALS: From **8** ft. to **30** ft. From ft. to ft.
 From ft. to ft. From ft. to ft.

6 GROUT MATERIAL: 1 Neat cement 2 Cement grout **3 Bentonite** **4 Other Concrete**
 Grout intervals: From **0** ft. to **3** ft. From **3** ft. to **8** ft. From ft. to ft.
 What is the nearest source of possible contamination:
 1 Septic tank 4 Lateral lines 7 Pit privy **11 Fuel storage** 14 Abandoned water well
 2 Sewer lines 5 Cess pool 8 Sewage lagoon 12 Fertilizer storage 15 Oil well/Gas well
 3 Watertight sewer lines 6 Seepage pit 9 Feedyard 13 Insecticide storage 16 Other (specify below)
 Direction from well? How many feet?

FROM	TO	LITHOLOGIC LOG	FROM	TO	PLUGGING INTERVALS
0	5	Clay,			
5	6.5	Clay, Brown			
6.5	10	Silt, Gray Brown			
10	11.2	Silt, clayey, Dark Brown			
11.2	15	Silt, clayey, Dark Brown			
15	19	Silt, clayey, Dark Brown			
19	20.9	Sand, m, Tan			
20.9	25	Silt, clayey, Dark Brown			
25	25.75	Sand, f, Brown			
25.75	26.75	Silt, clayey, Dark Brown			
26.75	28	Sand, f, coarsens w/depth, Dark Brown			
28	30	No Returns,			
					SVE-1

7 CONTRACTOR'S OR LANDOWNER'S CERTIFICATION: This water well was **(1)** constructed, (2) reconstructed, or (3) plugged under my jurisdiction and was completed on (mo/day/year) **11/10/2016** and this record is true to the best of my knowledge and belief.
 Kansas Water Well Contractor's License No. **527** This Water Well Record was completed on (mo/day/yr) **2/1/16**
 under the business name of **GeoCore, Inc.** by (signature) *Paul M*

OFFICE USE ONLY
T
R
EM
SEC