

**WATER WELL PLUGGING RECORD Form WWC-5P**

KSA 82a-1212

ID NO.

MW-2


<b>1 LOCATION OF WATER WELL:</b> County: <b>Shawnee</b>	Fraction <b>NW ¼ SE ¼ SW ¼ SE ¼</b>	Section Number <b>31</b>	Township Number <b>T 11 S</b>	Range Number <b>16</b> <input checked="" type="checkbox"/> E <input type="checkbox"/> W
--	--	-----------------------------	----------------------------------	--

Street/Rural Address of Well Location; if unknown, distance & direction from nearest town or intersection: If at owner's address, check here  1000 S. Kansas Avenue, Topeka,KS

**Global Positioning Systems (GPS) information:**  
 Latitude: 39.045366 (in decimal degrees)  
 Longitude: -95.675729 (in decimal degrees)  
 Elevation: 948.78  
 Horizontal Datum:  WGS84,  NAD83,  NAD27  
 Collection Method:

**2 WATER WELL OWNER:** Landmark Investors,LLC  
 RR#, St. Address, Box #: 22602 State Line Road  
 City, State ZIP Code: Bucyrus,KS 66013

GPS unit (Make/Model: Google Earth)  
 Digital Map/Photo,  Topographic Map,  Land Survey  
 Est. Accuracy:  < 3 m,  3-5 m,  5-15 m,  > 15 m

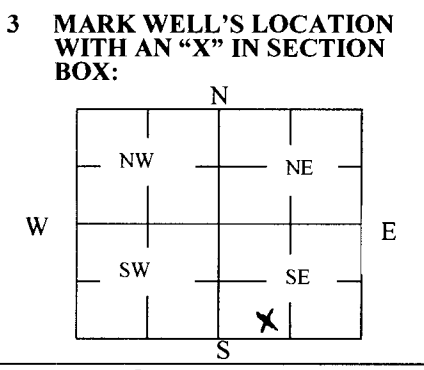

**4 DEPTH OF WELL** 26.5 ft.  
 WELL'S STATIC WATER LEVEL 25.65 ft  
 WELL WAS USED AS:  
 Domestic  Public Water Supply  Dewatering  
 Irrigation  Oil Field Water Supply  Monitoring  
 Feedlot  Domestic (Lawn & Garden)  Injection Well  
 Industrial  Air Conditioning  Other \_\_\_\_\_  
 Was a chemical/bacteriological sample submitted to Department? Yes  No

**5 TYPE OF BLANK CASING USED:**  
 Steel  RMP (SR)  Wrought  Fiberglass  Other (Specify below)  
 PVC  ABS  Asbestos-Cement  Concrete Tile  
 Blank casing diameter 2 in. Was casing pulled? Yes  No  If yes, how much 26.5  
 Casing height above or below land surface 0 in.

**6 GROUT PLUG MATERIAL:**  Neat cement  Cement grout  Bentonite  Other \_\_\_\_\_  
 Grout Plug Intervals: From 26.5 ft. to 1.0 ft., From 1.0 ft. to 0.0 ft., From \_\_\_\_\_ ft. to \_\_\_\_\_ ft.  
 What is the nearest source of possible contamination:  
 Septic tank  Seepage pit  Fuel storage  Other (specify below) unknown heavy metals  
 Sewer lines  Pit privy  Fertilizer storage  
 Watertight sewer lines  Sewage lagoon  Insecticide storage  
 Lateral lines  Feedyard  Abandoned water well Direction from well? east  
 Cess pool  Livestock pens  Oil well/Gas well How many feet? 45

FROM	TO	PLUGGING MATERIALS	FROM	TO	PLUGGING MATERIALS
26.5	1.0	bentonite chips	1.0	0.0	cement

**7 CONTRACTOR'S OR LANDOWNER'S CERTIFICATION:** This water well was plugged under my jurisdiction and was completed on (mo/day/year) 12/03/15 and this record is true to the best of my knowledge and belief. Kansas Water Well Contractor's License No. 753. This Water Well Record was completed on (mo/day/year) 01/06/2016 under the business name of Environmental Works, Inc. by (signature) [Signature]

Send one white copy to Kansas Department of Health & Environment, Geology Section, 1000 SW Jackson Street, Ste. 420, Topeka, KS 66612-1367. Send one copy to WATER WELL OWNER and retain one for your records.  
 Visit us at <http://www.kdheks.gov/waterwell/index.html> Telephone 785-296-5524.