

County: Shawnee Fraction SW NW SE Sec. 17 T 11 S R 16 (E/W)

CORRECTION(S) TO WATER WELL COMPLETION RECORD (WWC-5)  
(to rectify lacking or incorrect information)

Owner: KDHE

Location was listed as:

Section-Township-Range: 17 11S 6E

Fraction (1/4 1/4 1/4): SW NW SE

Location changed to:

17 11S 16E

SW NW SE

Other changes: Initial statements: \_\_\_\_\_

Changed to: sec 17 11S 16E

Comments: \_\_\_\_\_

Verification method: checked mapper program with address

initials: MS date: 08 18 2016


Submitted by: Kansas Geological Survey, Data Resources Library, 1930 Constant Ave., Lawrence, KS 66047-3726  
to: Kansas Dept of Health & Environment, Bureau of Water, 1000 SW Jackson, Suite 420, Topeka, KS 66612-1367.

1 LOCATION OF WATER WELL: Fraction **SW 1/4 NW 1/4 SE 1/4** Section Number **17** Township Number **T 11 S** Range Number **R 6 E**  
 County: **Shawnee**

Distance and direction from nearest town or city street address of well if located within city?  
**100 NE US Highway 24 Topeka, KS**

2 WATER WELL OWNER: **KDHE**  
 RR#, St. Address, Box # : **1000 SW Jackson, Suite 410** Board of Agriculture, Division of Water Resources  
 City, State, ZIP Code : **Topeka, KS 66612** Application Number:

3 LOCATE WELL'S LOCATION WITH AN "X" IN SECTION BOX:

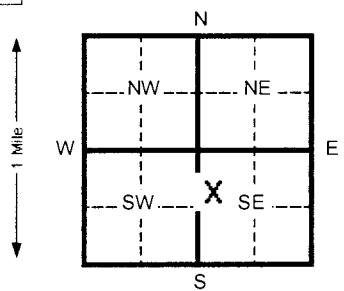

4 DEPTH OF COMPLETED WELL **35** ft. ELEVATION:  
 Depth(s) Groundwater Encountered 1.5 ft. 2 ft. 3 ft. Ft.  
 WELL'S STATIC WATER LEVEL \_\_\_\_\_ ft. below land surface measured on mo/day/yr  
 Pump test data: Well water was \_\_\_\_\_ Ft. after \_\_\_\_\_ hours pumping \_\_\_\_\_ Gpm  
 Est. Yield \_\_\_\_\_ Gpm: Well water was \_\_\_\_\_ Ft. after \_\_\_\_\_ Hours pumping \_\_\_\_\_ Gpm  
 Bore Hole Diameter **8.5** In. to **35** ft. and \_\_\_\_\_ in. to \_\_\_\_\_ Ft.  
 WELL WATER TO BE USED AS: 5 Public water supply 8 Air conditioning 11 Injection well  
 1 Domestic 3 Feed lot 6 Oil field water supply 9 Dewatering 12 Other (Specify below)  
 2 Irrigation 4 Industrial 7 Lawn and garden (domestic) 10 **Monitoring well** **AS-10**  
 Was a chemical/bacteriological sample submitted to Department? Yes \_\_\_\_\_ No **X** If yes, mo/day/yr sample was Submitted  
 Water Well Disinfected? Yes \_\_\_\_\_ No **X**

5 TYPE OF BLANK CASING USED:  
 1 Steel 3 RMP (SR) 5 Wrought Iron 8 Concrete tile CASING JOINTS: Glued \_\_\_\_\_ Clamped \_\_\_\_\_  
 2 **PVC** 4 ABS 6 Asbestos-Cement 9 Other (specify below) Welded \_\_\_\_\_  
 7 Fiberglass \_\_\_\_\_ **Threaded** **X**

Blank casing diameter **2** in. to **35** Dia \_\_\_\_\_ in. to \_\_\_\_\_ ft., Dia \_\_\_\_\_ in. to \_\_\_\_\_ ft.  
 Casing height above land surface **FLUSH** In., weight **SCH 40** Lbs./ft. Wall thickness or gauge No. \_\_\_\_\_

TYPE OF SCREEN OR PERFORATION MATERIAL:  
 1 Steel 3 Stainless steel 5 Fiberglass 8 **PVC** 10 Asbestos-cement  
 2 Brass 4 Galvanized steel 6 Concrete tile 9 RMP (SR) 11 Other (specify) \_\_\_\_\_  
 12 None used (open hole)

SCREEN OR PERFORATION OPENINGS ARE:  
 1 Continuous slot 3 **Mill slot** 6 Wire wrapped 9 Drilled holes  
 2 Louvered shutter 4 Key punched 7 Torch cut 10 Other (specify) \_\_\_\_\_  
 8 Saw cut 11 None (open hole)

SCREEN-PERFORATED INTERVALS: From **33** ft. to **35** ft. From \_\_\_\_\_ ft. to \_\_\_\_\_ ft.  
 From \_\_\_\_\_ ft. to \_\_\_\_\_ ft. From \_\_\_\_\_ ft. to \_\_\_\_\_ ft.  
 SAND PACK INTERVALS: From **31** ft. to **35** ft. From \_\_\_\_\_ ft. to \_\_\_\_\_ ft.  
 From \_\_\_\_\_ ft. to \_\_\_\_\_ ft. From \_\_\_\_\_ ft. to \_\_\_\_\_ ft.

6 GROUT MATERIAL: 1 Neat cement 2 Cement grout 3 **Bentonite** 4 Other \_\_\_\_\_  
 Grout Intervals From 2 **0.5** ft. to **3** Ft. From 3 **3** Ft. to **31** ft. From \_\_\_\_\_ ft. to \_\_\_\_\_ ft.

What is the nearest source of possible contamination:  
 1 Septic tank 4 Lateral lines 7 Pit privy 10 Livestock pens 14 Abandoned water well  
 2 Sewer lines 5 Cess pool 8 Sewage lagoon 11 Fuel storage 15 **Oil well/ Gas well**  
 3 Watertight sewer lines 6 Seepage pit 9 Feedyard 12 Fertilizer storage 16 **Other (specify below)**  
**Contaminated Site**  
 Direction from well? \_\_\_\_\_ How many feet? \_\_\_\_\_

FROM	TO	CODE	LITHOLOGIC LOG	FROM	TO	PLUGGING INTERVALS
0	0.5		Grass, Topsoil			
0.5	3		Clay			
3	12		1" Gravel (fill)			
12	30		Silt			
30	35		Sand			
35	TD		End of Borehole			

7 CONTRACTOR'S OR LANDOWNER'S CERTIFICATION: This water well was (x) constructed, (2) reconstructed, or (3) plugged under my jurisdiction and  
 Completed on (mo/day/yr) **01/26/16** And this record is true to the best of my knowledge and belief. Kansas  
 Water Well Contractor's License No. **585** This Water Well Record was completed on (mo/day/yr) **02/25/16**  
 under the business name of **Associated Environmental, Inc.** By (signature) **Bradley J. Johnson**

INSTRUCTIONS: Please fill in blanks and circle the correct answers. Send three copies to Kansas Department of Health and Environment, Bureau of Water, Topeka, Kansas 66620-0001. Telephone: 913-296-5545. Send one to WATER WELL OWNER and retain one for your records.

OFFICE USE ONLY

T

R

SEC