

WATER WELL RECORD Form WWC-5

Original Record Correction Change in Well Use


Division of Water Resources App. No.

40533

Well ID Well #5

1 LOCATION OF WATER WELL: County: Jefferson Fraction SW 1/4 SW 1/4 SE 1/4 SE 1/4 Section Number 13 Township Number T 11 S Range Number R 16 E W

2 WELL OWNER: Last Name: Business: Jefferson Co. RWD #1 Address: P.O. Box 266 City: Meriden State: KS ZIP: 66512 Street or Rural Address where well is located: From E Hwy 24 & N Hwy 4 at northeast side of Topeka. East ~1 mile on Hwy 24. Well is on north side of road, east of well #4.

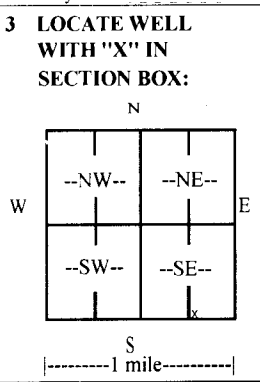

3 LOCATE WELL WITH 'X' IN SECTION BOX: 4 DEPTH OF COMPLETED WELL: 83.50 ft. Depth(s) Groundwater Encountered: 1) ft. 2) ft. 3) ft., or 4) Dry Well WELL'S STATIC WATER LEVEL: 29 ft. below land surface, measured on (mo-day-yr) 11/14/17

5 Latitude: 39.088596 (decimal degrees) Longitude: -95.580356 (decimal degrees) Horizontal Datum: WGS 84 NAD 83 NAD 27 Source for Latitude/Longitude: GPS (unit make/model: WAAS enabled? Yes No) Land Survey Topographic Map Online Mapper:

6 Elevation: Unknown ft. Ground Level TOC Source: Land Survey GPS Topographic Map Other

7 WELL WATER TO BE USED AS: 1. Domestic: Household Lawn & Garden Livestock Irrigation Feedlot Industrial 5. Public Water Supply: well ID Well #5 6. Dewatering: how many wells? 7. Aquifer Recharge: well ID 8. Monitoring: well ID 9. Environmental Remediation: well ID Air Sparge Soil Vapor Extraction Recovery Injection 10. Oil Field Water Supply: lease 11. Test Hole: well ID Cased Uncased Geotechnical 12. Geothermal: how many bores? a) Closed Loop Horizontal Vertical b) Open Loop Surface Discharge Inj. of Water 13. Other (specify):

Was a chemical/bacteriological sample submitted to KDHE? Yes No If yes, date sample was submitted: Water well disinfected? Yes No

8 TYPE OF CASING USED: Steel PVC CASING JOINTS: Glued Clamped Welded Threaded Other Certalok Casing diameter 12.75 in. to 57.50 ft., Diameter in. to ft., Diameter in. to ft. Casing height above land surface 12 in. Weight 18.89 lbs./ft. Wall thickness or gauge No. .750 TYPE OF SCREEN OR PERFORATION MATERIAL: Steel Stainless Steel Fiberglass PVC Other (Specify) Brass Galvanized Steel Concrete tile None used (open hole) SCREEN OR PERFORATION OPENINGS ARE: Continuous Slot Mill Slot Gauze Wrapped Torch Cut Drilled Holes Other (Specify) Louvered Shutter Key Punched Wire Wrapped Saw Cut None (Open Hole) SCREEN-PERFORATED INTERVALS: From 57.50 ft. to 82.50 ft., From ft. to ft., From ft. to ft. GRAVEL PACK INTERVALS: From 33 ft. to 83 ft., From ft. to ft., From ft. to ft.

9 GROUT MATERIAL: Neat cement Cement grout Bentonite Other Grout Intervals: From 10 ft. to 30 ft., From 30 ft. to 33 ft., From ft. to ft.

Nearest source of possible contamination: Septic Tank Lateral Lines Pit Privy Livestock Pens Insecticide Storage Sewer Lines Cess Pool Sewage Lagoon Fuel Storage Abandoned Water Well Watertight Sewer Lines Seepage Pit Feedyard Fertilizer Storage Oil Well/Gas Well Other (Specify) None Known Direction from well? Distance from well? ft.

Table with columns: 10 FROM, TO, LITHOLOGIC LOG, FROM, TO, LITHO. LOG (cont.) or PLUGGING INTERVALS. Rows include Topsoil, Clay, tan, Clay, brown, Clay, gray, Sand & gravel, medium, Sand & gravel, fine to coarse, Sand & gravel, medium to coarse, Sand & gravel, fine to medium, Limestone.

11 CONTRACTOR'S OR LANDOWNER'S CERTIFICATION: This water well was constructed, reconstructed, or plugged under my jurisdiction and was completed on (mo-day-year) 11/14/17 and this record is true to the best of my knowledge and belief. Kansas Water Well Contractor's License No. 185 This Water Well Record was completed on (mo-day-year) 11/17/17 under the business name of Clarke Well & Equipment, Inc. Signature