


**WATER WELL PLUGGING RECORD Form WWC-5P**
**KSA 82a-1212 ID NO. MW11**

<b>1 LOCATION OF WATER WELL:</b> County: <b>Shawnee</b>		Fraction <b>NW 1/4 NW 1/4 SW 1/4 NE 1/4</b>	Section Number <b>31</b>	Township Number <b>11 S</b>	Range Number <b>16</b> <input checked="" type="checkbox"/> E <input type="checkbox"/> W	
Street/Rural Address of Well Location; if unknown, distance and direction from nearest town or intersection. If at owner's address, check here <input type="checkbox"/>  <b>506 SW Topeka Blvd., Topeka</b>			<b>Global Positioning Systems (GPS) Information:</b> Latitude: <u>39.05485</u> (in decimal degrees) Longitude: <u>-95.67856</u> (in decimal degrees) Elevation: _____ Datum: <input type="checkbox"/> WGS84 <input checked="" type="checkbox"/> NAD83 <input type="checkbox"/> NAD27 Collection Method: <input type="checkbox"/> GPS unit Make/Model: _____ <input type="checkbox"/> Digital Map/Photo <input type="checkbox"/> Topographic Map <input checked="" type="checkbox"/> Land Survey Est. Accuracy: <input type="checkbox"/> <3 m <input type="checkbox"/> 3-5 m <input type="checkbox"/> 5-15 m <input type="checkbox"/> >15 m	
			<b>2 WATER WELL OWNER:</b> MRP Properties, Inc. RR#, St. Address, Box # <b>5590 Havana St. Unit B</b> City, State ZIP Code <b>Denver, CO 80239</b>	
<b>3 MARK WELL'S LOCATION WITH AN "X" IN SECTION BOX:</b> <div style="text-align: center;">                     N  <table border="1" style="margin: auto; border-collapse: collapse;"> <tr> <td style="padding: 5px;">NW</td> <td style="text-align: center; padding: 5px;">X</td> <td style="padding: 5px;">NE</td> </tr> <tr> <td style="padding: 5px;">SW</td> <td></td> <td style="padding: 5px;">SE</td> </tr> </table>                     S                      W                      E                 </div>		NW	X	NE	SW		SE	<b>4 DEPTH OF WELL:</b> <u>19.5</u> ft. WELL'S STATIC WATER LEVEL: <u>Dry</u> ft. BTOC WELL WAS USED AS: <div style="display: flex; justify-content: space-between;"> <div> <input type="checkbox"/> Domestic  <input type="checkbox"/> Irrigation  <input type="checkbox"/> Feedlot  <input type="checkbox"/> Industrial                         </div> <div> <input type="checkbox"/> Public Water Supply  <input type="checkbox"/> Old Field Water Supply  <input type="checkbox"/> Domestic (Lawn/Garden)  <input type="checkbox"/> Air Conditioning                         </div> <div> <input type="checkbox"/> Dewatering  <input checked="" type="checkbox"/> Monitoring  <input type="checkbox"/> Injection Well  <input type="checkbox"/> Other _____                         </div> </div> Was a chemical/bacteriological sample submitted to Department? <input type="checkbox"/> Yes <input checked="" type="checkbox"/> No	
NW	X	NE	
SW		SE	
<b>5 TYPE OF BLANK CASING USED:</b> <div style="display: flex; flex-wrap: wrap;"> <div style="width: 50%;"><input type="checkbox"/> Steel</div> <div style="width: 50%;"><input type="checkbox"/> RMP (SR)</div> <div style="width: 50%;"><input type="checkbox"/> Wrought</div> <div style="width: 50%;"><input type="checkbox"/> Fiberglass</div> <div style="width: 50%;"><input checked="" type="checkbox"/> PVC</div> <div style="width: 50%;"><input type="checkbox"/> ABS</div> <div style="width: 50%;"><input type="checkbox"/> Asbestos/Cement</div> <div style="width: 50%;"><input type="checkbox"/> Concrete Tile</div> <div style="width: 50%;"><input type="checkbox"/> Other: _____</div> </div> Blank casing diameter: <u>2</u> in. Was casing pulled? <input checked="" type="checkbox"/> Yes <input type="checkbox"/> No If Yes, how much <u>3'</u> Casing height above or below land surface: _____ in.	
<b>6 GROUT PLUG MATERIAL:</b> <input type="checkbox"/> Neat cement <input type="checkbox"/> Cement grout <input checked="" type="checkbox"/> Bentonite <input type="checkbox"/> Other: _____ Grout Plug Intervals: From <u>3</u> ft. To <u>20</u> ft. From _____ ft. To _____ ft. From _____ ft. To _____ ft. What is the nearest source of possible contamination: <div style="display: flex; flex-wrap: wrap;"> <div style="width: 50%;"><input type="checkbox"/> Septic tank</div> <div style="width: 50%;"><input type="checkbox"/> Seepage pit</div> <div style="width: 50%;"><input checked="" type="checkbox"/> Fuel storage</div> <div style="width: 50%;"><input type="checkbox"/> Other (specify below): _____</div> <div style="width: 50%;"><input type="checkbox"/> Sewer lines</div> <div style="width: 50%;"><input type="checkbox"/> Pit privy</div> <div style="width: 50%;"><input type="checkbox"/> Fertilizer storage</div> <div style="width: 50%;"></div> <div style="width: 50%;"><input type="checkbox"/> Watertight sewer lines</div> <div style="width: 50%;"><input type="checkbox"/> Sewage lagoon</div> <div style="width: 50%;"><input type="checkbox"/> Insecticide storage</div> <div style="width: 50%;"></div> <div style="width: 50%;"><input type="checkbox"/> Lateral lines</div> <div style="width: 50%;"><input type="checkbox"/> Feedyard</div> <div style="width: 50%;"><input type="checkbox"/> Abandoned water well</div> <div style="width: 50%;"></div> <div style="width: 50%;"><input type="checkbox"/> Cess pool</div> <div style="width: 50%;"><input type="checkbox"/> Livestock pens</div> <div style="width: 50%;"><input type="checkbox"/> Oil well/Gas well</div> <div style="width: 50%;"></div> </div> Direction from well: <u>Southeast</u> How many feet: <u>265'</u>	
<table border="1" style="width:100%; border-collapse: collapse;"> <thead> <tr> <th style="width:10%;">FROM</th> <th style="width:10%;">TO</th> <th style="width:40%;">PLUGGING MATERIAL</th> <th style="width:10%;">FROM</th> <th style="width:10%;">TO</th> <th style="width:40%;">PLUGGING MATERIAL</th> </tr> </thead> <tbody> <tr> <td>0</td> <td>3</td> <td>Native soil</td> <td></td> <td></td> <td></td> </tr> <tr> <td>3</td> <td>20</td> <td>Bentonite</td> <td></td> <td></td> <td></td> </tr> <tr> <td></td> <td></td> <td></td> <td></td> <td></td> <td>MW11</td> </tr> <tr><td></td><td></td><td></td><td></td><td></td><td></td></tr> <tr><td></td><td></td><td></td><td></td><td></td><td></td></tr> <tr><td></td><td></td><td></td><td></td><td></td><td></td></tr> <tr><td></td><td></td><td></td><td></td><td></td><td></td></tr> <tr><td></td><td></td><td></td><td></td><td></td><td></td></tr> </tbody> </table>						FROM	TO	PLUGGING MATERIAL	FROM	TO	PLUGGING MATERIAL	0	3	Native soil				3	20	Bentonite									MW11																														
FROM	TO	PLUGGING MATERIAL	FROM	TO	PLUGGING MATERIAL	
0	3	Native soil	
3	20	Bentonite	
					MW11	
<b>7 CONTRACTOR'S OR LANDOWNER'S CERTIFICATION:</b> This water well was plugged under my jurisdiction and was completed on (mo/day/year) <u>7/14/2020</u> and this record is true to the best of my knowledge and belief. Kansas Water Well Contractor's License No. <u>527</u> . This Water Well Record was completed on (mo/day/year) <u>7/15/2020</u> under the business name of <u>GeoCore, LLC</u> by (signature) <u>[Signature]</u> .	
<b>INSTRUCTIONS:</b> Use typewriter or ballpoint pen. Please press firmly and print clearly. Please fill in blanks, underline or circle the correct answers. Send one copy to Kansas Department of Health and Environment, Bureau of Water, Geology Section, 1000 SW Jackson St., Ste. 420, Topeka, Kansas 66612-1367. Telephone 785/296-5524. Send one to Water Well Owner and retain one for your records. Visit us at <a href="http://www.kdheks.gov/waterwell/index.html">http://www.kdheks.gov/waterwell/index.html</a> .	

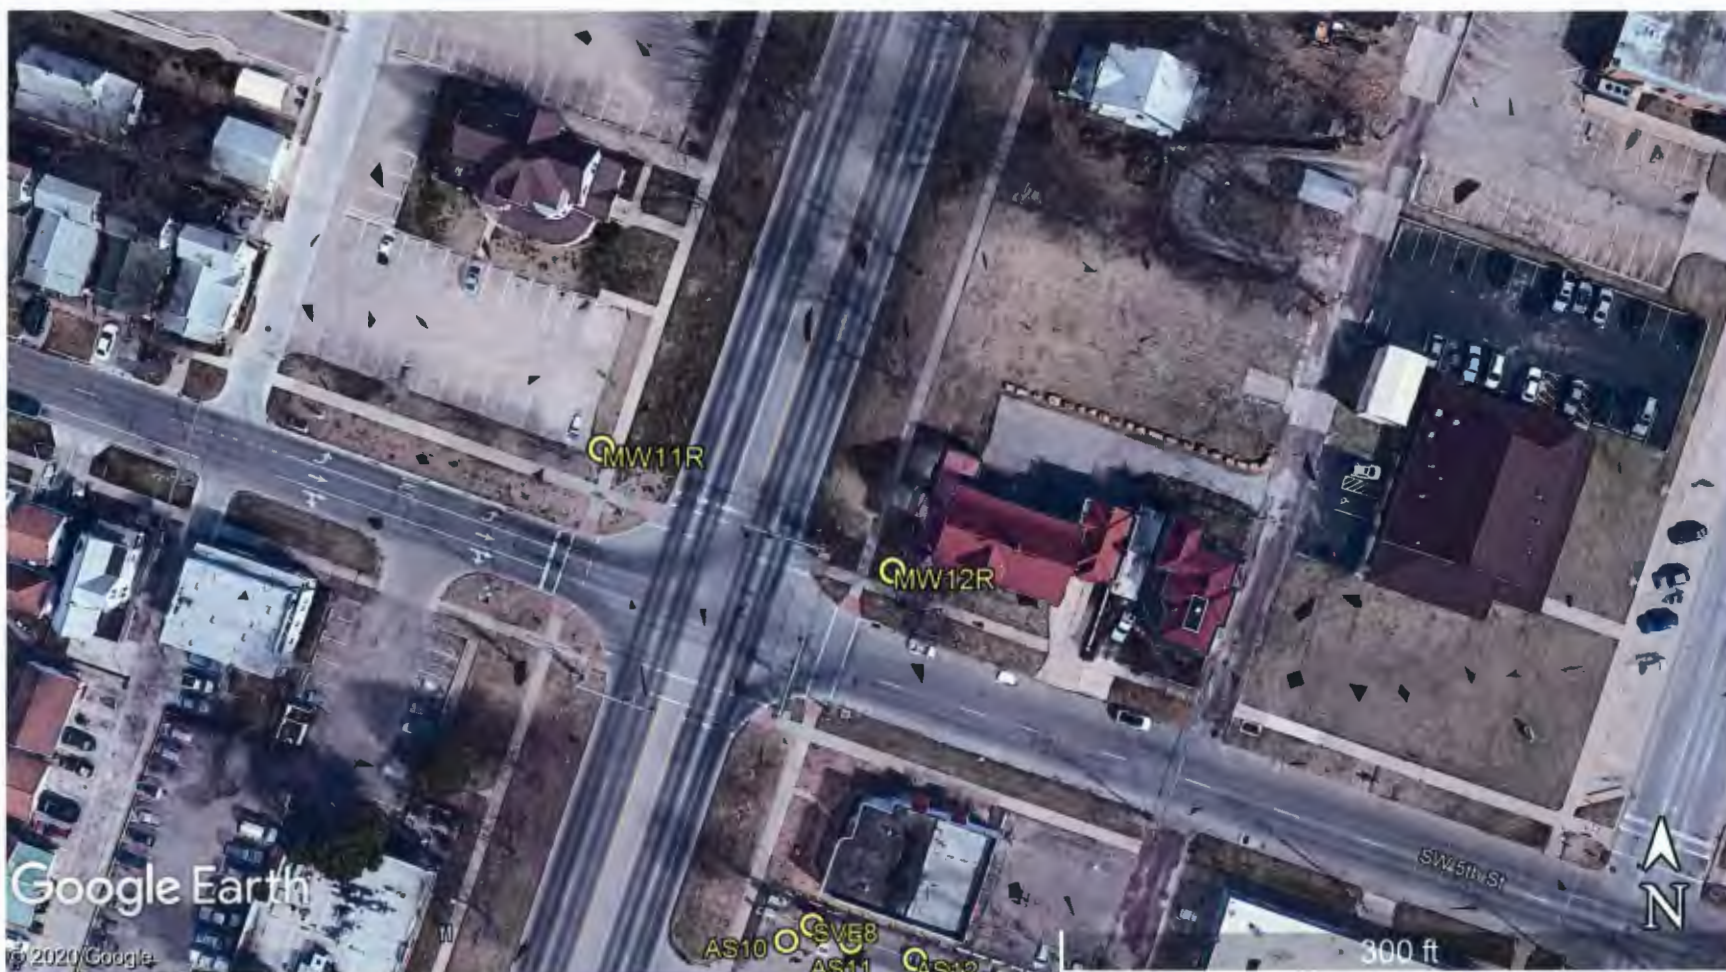

Project Site:  
**Former Valero #4172, 506 SW Topeka Blvd., Topeka, Kansas**  
 KDHE Project Code: U4-089-14510

GPS Coordinates:

MW11R: 39.054850, -95.678553

MW12R: 39.054706, -95.678099

RECEIVED  
 JUL 29 2020  
 BUREAU OF WATER

Shawnee

31-11-16E