

County: Shawnee Fraction: NE NW SE NE Sec. 31 T. 11 S R. 16 E

**CORRECTION(S) to WATER WELL COMPLETION RECORD Form WWC-5 (to rectify lacking or incorrect information)**

Owner: KDHE KSMW 7

<b>If location corrected, was listed as:</b>	<b>Location changed to:</b>
Section-Township-Range: <u>30-22-16E</u>	<u>31-11-16E</u>
Fraction (1/4 calls): _____	_____

**Other changes:** Initial statements: \_\_\_\_\_

Changed to: Latitude was changed from 37.05428 to 39.05431

Comments: \_\_\_\_\_

Verification method: KGS Mapper, LEOWEB, Site Map

Initials: SH Date: 11-18-2022

Submitted by:  Kansas Geological Survey, Data Resources Library, 1930 Constant Ave., Lawrence, KS 66047-3724  
 Kansas Dept. of Health & Environment, Bureau of Water, 1000 SW Jackson, Suite 420, Topeka, KS 66612-1367

WATER WELL RECORD Form WWC-5

Division of Water Resources App. No.


KSMW-7

Original Record Correction Change in Well Use

Well ID

1 LOCATION OF WATER WELL: County: Shawnee Fraction NE 1/4 NW 1/4 SE 1/4 NE 1/4 Section Number 30 Township Number T 22 S Range Number R 16 E W

2 WELL OWNER: Last Name: Business: KDHE Address: 1000 SW Jackson St. City: Topeka State: KS ZIP: 66612 Street or Rural Address where well is located (if unknown, distance and direction from nearest town or intersection): If at owner's address, check here: 400 & 424 South Kansas Ave Topeka, KS 66612

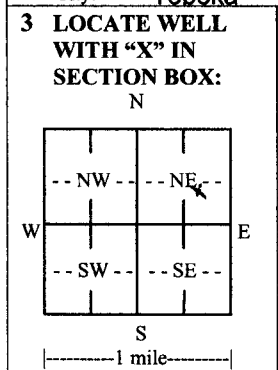

3 LOCATE WELL WITH 'X' IN SECTION BOX: N W E S

4 DEPTH OF COMPLETED WELL: 28.0 ft. Depth(s) Groundwater Encountered: 1) 31 ft. 2) N/A ft. 3) N/A ft., or 4) Dry Well WELL'S STATIC WATER LEVEL: 31.12 ft. below land surface, measured on (mo-day-yr) 2/16/2022

5 Latitude: 37.05431 (decimal degrees) Longitude: -95.67204 (decimal degrees) Horizontal Datum: WGS 84 NAD 83 NAD 27 Source for Latitude/Longitude: GPS (unit make/model): (WAAS enabled? Yes No) Land Survey Topographic Map Online Mapper:

6 Elevation: 922.82 ft. Ground Level TOC Source: Land Survey GPS Topographic Map Other

7 WELL WATER TO BE USED AS: 1. Domestic: Household Lawn & Garden Livestock Irrigation Feedlot Industrial 2. Public Water Supply: well ID 3. Dewatering: how many wells? 4. Aquifer Recharge: well ID 5. Monitoring: well ID KSMW-7 6. Environmental Remediation: well ID Air Sparge Soil Vapor Extraction Recovery Injection 7. Oil Field Water Supply: lease 8. Test Hole: well ID Cased Uncased Geotechnical 9. Geothermal: how many bores? a) Closed Loop Horizontal Vertical b) Open Loop Surface Discharge Inj. of Water 10. Other (specify):

Was a chemical/bacteriological sample submitted to KDHE? Yes No If yes, date sample was submitted: Water well disinfected? Yes No

8 TYPE OF CASING USED: Steel PVC Other CASING JOINTS: Glued Clamped Welded Threaded Casing diameter 2 in. to 12.0 ft., Diameter N/A in. to N/A ft., Diameter N/A in. to N/A ft. Casing height above land surface 0 in. Weight N/A lbs./ft. Wall thickness or gauge No. Sch. 40 TYPE OF SCREEN OR PERFORATION MATERIAL: Steel Stainless Steel Fiberglass PVC Other (Specify) Brass Galvanized Steel Concrete tile None used (open hole) SCREEN OR PERFORATION OPENINGS ARE: Continuous Slot Mill Slot Gauze Wrapped Torch Cut Drilled Holes Other (Specify) Louvered Shutter Key Punched Wire Wrapped Saw Cut None (Open Hole) SCREEN-PERFORATED INTERVALS: From 12.0 ft. to 32.0 ft., From N/A ft. to N/A ft., From N/A ft. to N/A ft. GRAVEL PACK INTERVALS: From 10.0 ft. to 32.0 ft., From N/A ft. to N/A ft., From N/A ft. to N/A ft.

9 GROUT MATERIAL: Neat cement Cement grout Bentonite Other Concrete 0 to 2 Grout Intervals: From 2 ft. to 10.0 ft., From N/A ft. to N/A ft., From N/A ft. to N/A ft. Nearest source of possible contamination: Septic Tank Lateral Lines Pit Privy Livestock Pens Insecticide Storage Sewer Lines Cess Pool Sewage Lagoon Fuel Storage Abandoned Water Well Watertight Sewer Lines Seepage Pit Feedyard Fertilizer Storage Oil Well/Gas Well Other (Specify) Direction from well? Distance from well? ft.

10 FROM	TO	LITHOLOGIC LOG	FROM	TO	LITHO. LOG (cont.) or PLUGGING INTERVALS
		Detailed boring logs attached			

11 CONTRACTOR'S OR LANDOWNER'S CERTIFICATION: This water well was constructed, reconstructed, or plugged under my jurisdiction and was completed on (mo-day-year) 2/16/2022 and this record is true to the best of my knowledge and belief. Kansas Water Well Contractor's License No. 759 This Water Well Record was completed on (mo-day-year) 3/13/2022 under the business name of RAZEK Environmental, LLC Signature

Project: <b>PCE-South Kansas Avenue (Montgomery Ward)</b> Project Location: <b>320 South Kansas Avenue, Topeka, Kansas</b> Project Number: <b>C4-089-73558</b>	<b>ppB enviro-solutions</b> 112 SW 6th Ave., Suite 201 Topeka, Kansas 785.256.0045	<b>Log of Boring KSMW-7</b> <b>Sheet 1 of 2</b>
--	---	--

Date(s) Drilled: <b>2/16/22</b>	Logged By: <b>J. Murphy</b>	Checked By: <b>R. Weiser</b>
Drilling Method: <b>Hollow-Stem Auger/Air Rotary</b>	Drill String: <b>8.25-in OD HSA/6-in OD roller bit with air</b>	Total Depth of Borehole: <b>32</b>
Drill Rig Type: <b>Geoprobe Model 7822 DT</b>	Drilling Contractor: <b>Razek - Tony Poulter</b>	Surface Elevation: <b>922.82</b>
Static Water Level and GW Elevation: <b>31.12</b>	Sampling Method(s): <b>NA</b>	TOC Elevation: <b>922.32</b>
Borehole Backfill: <b>Well Completion</b>	Location: <b>Northwest corner of property</b>	

Elevation (feet)	Depth (feet)	Sample Type	Sample Number	PID Reading, ppm	Material Type	Graphic Log	MATERIAL DESCRIPTION	Well Log	REMARKS AND OTHER TESTS
922.82	0						Woodchips/topsoil		
					CL		Brown clay, moist		
917.82	5				CL		Tan/gray sandy clay, moist		
912.82	10				CL		Gray/green sandy clay, petroleum odor		
907.82	15				Limestone		Brown limestone		
902.82	20				Shale		Gray shale		
897.82	25								
892.82	30								

Macintosh\_HD-private-var:folders: z:56kdr\_ ts329519bz02sww64c0000gn:T:TemporaryItems:boring temp:tmpfile.bgsl[PPB Well.tbl]

Project: PCE-South Kansas Avenue  
(Montgomery Ward)  
Project Location: 320 South Kansas Avenue,  
Topeka, Kansas  
Project Number: C4-089-73558

**ppB enviro-solutions**  
112 SW 6th Ave., Suite 201  
Topeka, Kansas  
785.256.0045


**Log of Boring KSMW-7**  
**Sheet 2 of 2**

Elevation (feet)	Depth (feet)	Sample Type	Sample Number	PID Reading, ppm	Material Type	Graphic Log	MATERIAL DESCRIPTION	Well Log	REMARKS AND OTHER TESTS
892.82	30				Shale		Gray shale		
887.82	35								
882.82	40								
877.82	45								
872.82	50								
867.82	55								
862.82	60								
857.82	65								

Macintosh HD:\private\var\folders: z:56kdr\_ ts329518bz02sxxw64c0000gn:T:\Temporary\Items\borings\_temp\mp\file.bgs\ppb Well.tbl



- Legend**
- SI Proposed Wells
  - Water
  - Stormwater
  - Sewer
  - Parcel Boundary

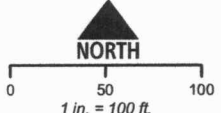

**FIGURE 3  
MONITORING WELL LOCATIONS**

**PCE - SOUTH KANSAS AVENUE - SITE INSPECTION  
400 AND 424 SOUTH KANSAS AVENUE, TOPEKA, KANSAS**

**KDHE#: C4-089-73558**

Source: NAIP 2019 and 2021 Google Earth || Location: NE 1/4 of Sec 31 - T11S - R16E, Shawnee County, KS



Drawn By: J Polak

Project Manager: J Polak

Date: 10/13/2021