


**1 LOCATION OF WATER WELL:** Fraction NW 1/4 SW 1/4 NE 1/4 Section Number 31 Township Number T 11 S Range Number 16  E  W  
 County: Shawnee

Street/Rural Address of Well Location; if unknown, distance & direction from nearest town or intersection: If at owner's address, check here  506 SW Topeka Blvd. Topeka, KS

**Global Positioning Systems (GPS) information:**  
 Latitude: 39.05400 (in decimal degrees)  
 Longitude: -95.67818 (in decimal degrees)  
 Elevation: 933.7 KGSDBL - 2/7/2023  
 Horizontal Datum:  WGS84,  NAD83,  NAD27  
 Collection Method:

**2 WATER WELL OWNER:** Circle K Stores, Inc.  
 RR#, St. Address, Box #: 1100 Situs Ct., Suite 100  
 City, State ZIP Code: Raleigh, NC 27606

GPS unit (Make/Model: \_\_\_\_\_)  
 Digital Map/Photo,  Topographic Map,  Land Survey  
 Est. Accuracy:  < 3 m,  3-5 m,  5-15 m,  > 15 m

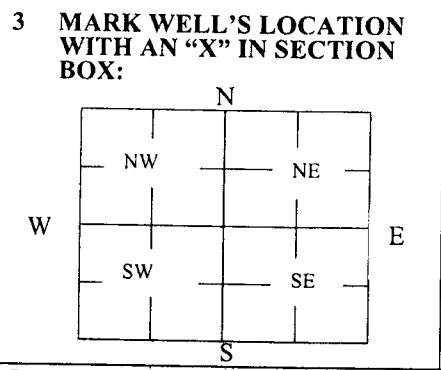

**4 DEPTH OF WELL** 25 ft.  
 WELL'S STATIC WATER LEVEL \_\_\_\_\_ ft.  
 WELL WAS USED AS:  
 Domestic  Public Water Supply  Dewatering  
 Irrigation  Oil Field Water Supply  Monitoring  
 Feedlot  Domestic (Lawn & Garden)  Injection Well  
 Industrial  Air Conditioning  Other Air Sparge  
 Was a chemical/bacteriological sample submitted to Department? Yes  No

**5 TYPE OF BLANK CASING USED:**  
 Steel  RMP (SR)  Wrought  Fiberglass  Other (Specify below)  
 PVC  ABS  Asbestos-Cement  Concrete Tile  
 Blank casing diameter 2 in. Was casing pulled? Yes  No  If yes, how much ~3ft. below ground surface  
 Casing height above or below land surface \_\_\_\_\_ in.

**6 GROUT PLUG MATERIAL:**  Neat cement  Cement grout  Bentonite  Other \_\_\_\_\_  
 Grout Plug Intervals: From 3 ft. to 25 ft., From \_\_\_\_\_ ft. to \_\_\_\_\_ ft., From \_\_\_\_\_ ft. to \_\_\_\_\_ ft.  
 What is the nearest source of possible contamination:  
 Septic tank  Seepage pit  Fuel storage  Other (specify below)  
 Sewer lines  Pit privy  Fertilizer storage  
 Watertight sewer lines  Sewage lagoon  Insecticide storage  
 Lateral lines  Feedyard  Abandoned water well  Direction from well? \_\_\_\_\_  
 Cess pool  Livestock pens  Oil well/Gas well  How many feet? \_\_\_\_\_

FROM	TO	PLUGGING MATERIALS	FROM	TO	PLUGGING MATERIALS
3	25	Bentonite			

**7 CONTRACTOR'S OR LANDOWNER'S CERTIFICATION:** This water well was plugged under my jurisdiction and was completed on (mo/day/year) 6/29/22 and this record is true to the best of my knowledge and belief. Kansas Water Well Contractor's License No. \_\_\_\_\_. This Water Well Record was completed on (mo/day/year) 10/5/2022 under the business name of GreenField Contractors, Inc. by (signature) Melise D. McElwain

Send one white copy to Kansas Department of Health & Environment, Geology Section, 1000 SW Jackson Street, Ste. 420, Topeka, KS 66612-1367. Send one copy to WATER WELL OWNER and retain one for your records.  
 Visit us at <http://www.kdheks.gov/waterwell/index.html> Telephone 785-296-5524.

Shawnee

31-11-16E



Valero #4172, 506 SW Topeka Blvd., Topeka  
 KDHE Project Code U4 089 14510

GPS Coordinates:

AS2: 39.05397, -95.67805	AS10: 39.05426, -95.67826	SVE5: 39.05398, -95.67812
AS3: 39.05400, -95.67818	AS11: 39.05426, -95.67816	SVE6: 39.05404, -95.67834
AS4: 39.05407, -95.67817	AS12: 39.05424, -95.67806	SVE7: 39.05417, -95.67830
AS5: 39.05418, -95.67812	AS13: 39.05421, -95.67795	SVE8: 39.05428, -95.67822