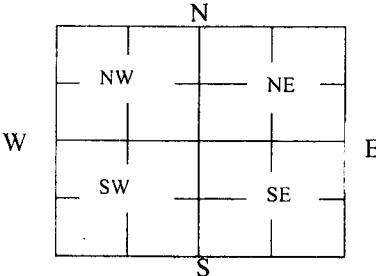


1 LOCATION OF WATER WELL: County: <u>Shawnee</u>	Fraction <u>NW 1/4 SW 1/4 NE 1/4</u>	Section Number <u>31</u>	Township Number <u>T 11 S</u>	Range Number <u>16</u> <input checked="" type="checkbox"/> E <input type="checkbox"/> W
Street/Rural Address of Well Location; if unknown, distance & direction from nearest town or intersection: If at owner's address, check here <input type="checkbox"/> <u>506 SW Topeka Blvd. Topeka, KS</u>		Global Positioning Systems (GPS) information: Latitude: <u>39.05414</u> (in decimal degrees) Longitude: <u>-95.67831</u> (in decimal degrees) Elevation: <u>932.6</u> Horizontal Datum: <input type="checkbox"/> WGS84, <input checked="" type="checkbox"/> NAD83, <input type="checkbox"/> NAD27 Collection Method: <input type="checkbox"/> GPS unit (Make/Model: _____) <input type="checkbox"/> Digital Map/Photo, <input type="checkbox"/> Topographic Map, <input type="checkbox"/> Land Survey Est. Accuracy: <input type="checkbox"/> < 3 m, <input type="checkbox"/> 3-5 m, <input type="checkbox"/> 5-15 m, <input type="checkbox"/> > 15 m		

2 WATER WELL OWNER: <u>Circle K Stores, Inc.</u> RR#, St. Address, Box #: <u>1100 Situs Ct., Suite 100</u> City, State ZIP Code: <u>Raleigh, NC 27606</u>	
--	--

3 MARK WELL'S LOCATION WITH AN "X" IN SECTION BOX: 	4 DEPTH OF WELL <u>23</u> ft. WELL'S STATIC WATER LEVEL _____ ft WELL WAS USED AS: <input type="checkbox"/> Domestic <input type="checkbox"/> Public Water Supply <input type="checkbox"/> Dewatering <input type="checkbox"/> Irrigation <input type="checkbox"/> Oil Field Water Supply <input type="checkbox"/> Monitoring <input type="checkbox"/> Feedlot <input type="checkbox"/> Domestic (Lawn & Garden) <input type="checkbox"/> Injection Well <input type="checkbox"/> Industrial <input checked="" type="checkbox"/> Air Conditioning <input checked="" type="checkbox"/> Other <u>Air Sparge</u> Was a chemical/bacteriological sample submitted to Department? Yes <input type="checkbox"/> No <input type="checkbox"/>
---	---

5 TYPE OF BLANK CASING USED:

Steel RMP (SR) Wrought Fiberglass Other (Specify below) _____
 PVC ABS Asbestos-Cement Concrete Tile

Blank casing diameter 2 in. Was casing pulled? Yes No If yes, how much ~3ft. below ground surface
 Casing height above or below land surface _____ in.

6 GROUT PLUG MATERIAL: Neat cement Cement grout Bentonite Other _____

Grout Plug Intervals: From 3 ft. to 23 ft., From _____ ft. to _____ ft., From _____ ft. to _____ ft.

What is the nearest source of possible contamination:
 Septic tank Seepage pit Fuel storage Other (specify below) _____
 Sewer lines Pit privy Fertilizer storage _____
 Watertight sewer lines Sewage lagoon Insecticide storage _____
 Lateral lines Feedyard Abandoned water well Direction from well? _____
 Cess pool Livestock pens Oil well/Gas well How many feet? _____

FROM	TO	PLUGGING MATERIALS	FROM	TO	PLUGGING MATERIALS
3	23	Bentonite			

7 CONTRACTOR'S OR LANDOWNER'S CERTIFICATION: This water well was plugged under my jurisdiction and was completed on (mo/day/year) 6/29/22 and this record is true to the best of my knowledge and belief. Kansas Water Well Contractor's License No. _____. This Water Well Record was completed on (mo/day/year) 10/5/2022 under the business name of GreenField Contractors, Inc. by (signature) Melissa D. Melhuus

Send one white copy to Kansas Department of Health & Environment, Geology Section, 1000 SW Jackson Street, Ste. 420, Topeka, KS 66612-1367. Send one copy to WATER WELL OWNER and retain one for your records.
 Visit us at <http://www.kdheks.gov/waterwell/index.html> Telephone 785-296-5524.

Shawnee

31-11-16E



Valero #4172, 506 SW Topeka Blvd., Topeka
 KDHE Project Code U4 089 14510

GPS Coordinates:

AS2: 39.05397, -95.67805	AS10: 39.05426, -95.67826	SVE5: 39.05398, -95.67812
AS3: 39.05400, -95.67818	AS11: 39.05426, -95.67816	SVE6: 39.05404, -95.67834
AS4: 39.05407, -95.67817	AS12: 39.05424, -95.67806	SVE7: 39.05417, -95.67830
AS5: 39.05418, -95.67812	AS13: 39.05421, -95.67795	SVE8: 39.05428, -95.67822
		SVE9: 39.05422, -95.67800

lat 39.054119° lon -95.678165° elev 932 ft eye alt 1306 ft