

## WATER WELL PLUGGING RECORD

Form WWC-5P

KSA 82a-1212 ID NO.

SVE-5

1 LOCATION OF WATER WELL:	Fraction County: Shawnee NW $\frac{1}{4}$ SW $\frac{1}{4}$ NE $\frac{1}{4}$	Section Number 31	Township Number T 11 S	Range Number 16
---------------------------	---	----------------------	---------------------------	--------------------

Street/Rural Address of Well Location; if unknown, distance & direction from nearest town or intersection: If at owner's address, check here  506 SW Topeka Blvd.  
Topeka, KS


## Global Positioning Systems (GPS) information:

Latitude: 39.05398 (in decimal degrees)  
Longitude: -95.67812 (in decimal degrees)  
Elevation: 934.01 *Locs Dr 1 2-7-2022*  
Horizontal Datum:  WGS84,  NAD83,  NAD27  
Collection Method:

2 WATER WELL OWNER: Circle K Stores, Inc.  
RR#, St. Address, Box #: 1100 Situs Ct., Suite 100  
City, State ZIP Code: Raleigh, NC 27606

GPS unit (Make/Model): \_\_\_\_\_  
 Digital Map/Photo,  Topographic Map,  Land Survey  
Est. Accuracy:  < 3 m,  3-5 m,  5-15 m,  > 15 m

3 MARK WELL'S LOCATION WITH AN "X" IN SECTION BOX:

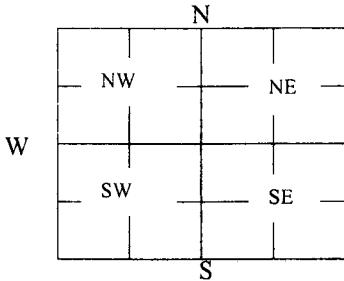

4 DEPTH OF WELL 20 ft.

WELL'S STATIC WATER LEVEL \_\_\_\_\_ ft

WELL WAS USED AS:

Domestic  
 Irrigation  
 Feedlot  
 Industrial

Public Water Supply  
 Oil Field Water Supply  
 Domestic (Lawn & Garden)  
 Air Conditioning

Dewatering  
 Monitoring  
 Injection Well  
 Other SVE

Was a chemical/bacteriological sample submitted to Department? Yes  No

5 TYPE OF BLANK CASING USED:

Steel  
 PVC

RMP (SR)  
 ABS

Wrought  
Asbestos-Cement

Fiberglass  
Concrete Tile

Other (Specify below)

Blank casing diameter 4 in. Was casing pulled? Yes  No  If yes, how much ~3ft. below ground surface  
Casing height above or below land surface \_\_\_\_\_ in.

6 GROUT PLUG MATERIAL:  Neat cement  Cement grout  Bentonite  Other \_\_\_\_\_

Grout Plug Intervals: From 3 ft. to 20 ft., From \_\_\_\_\_ ft. to \_\_\_\_\_ ft., From \_\_\_\_\_ ft. to \_\_\_\_\_ ft.

What is the nearest source of possible contamination:

Septic tank  
 Sewer lines  
 Watertight sewer lines  
 Lateral lines  
 Cess pool

Seepage pit  
 Pit privy  
 Sewage lagoon  
 Feedyard  
 Livestock pens

Fuel storage  
Fertilizer storage  
Insecticide storage  
Abandoned water well  
Oil well/Gas well

Other (specify below)

Direction from well? \_\_\_\_\_

How many feet? \_\_\_\_\_

FROM	TO	PLUGGING MATERIALS	FROM	TO	PLUGGING MATERIALS
3	20	Bentonite			
					U4-089-14510

7 CONTRACTOR'S OR LANDOWNER'S CERTIFICATION: This water well was plugged under my jurisdiction and was completed on (mo/day/year) 6/29/22 and this record is true to the best of my knowledge and belief. Kansas Water Well Contractor's License No. \_\_\_\_\_ This Water Well Record was completed on (mo/day/year) 10/5/2022 under the business name of GreenField Contractors, Inc. by (signature) *Melissa D. McElwee*

Send one white copy to Kansas Department of Health & Environment, Geology Section, 1000 SW Jackson Street, Ste. 420, Topeka, KS 66612-1367. Send one copy to WATER WELL OWNER and retain one for your records.  
Visit us at <http://www.kdheks.gov/waterwell/index.html> Telephone 785-296-5524.

Shawnee

31-11-16E



Valero #4172, 506 SW Topeka Blvd., Topeka  
KDHE Project Code U4 089 14510

GPS Coordinates:

AS2: 39.05397, -95.67805	AS6: 39.05402, -95.67826	SVE5: 39.05398, -95.67812
AS3: 39.05400, -95.67818	AS7: 39.05407, -95.67834	SVE6: 39.05404, -95.67834
AS4: 39.05407, -95.67817	AS8: 39.05414, -95.67831	SVE7: 39.05417, -95.67830
AS5: 39.05418, -95.67812	AS9: 39.05420, -95.67828	SVE8: 39.05421, -95.67795
AS10: 39.05426, -95.67826	AS11: 39.05426, -95.67816	SVE9: 39.05422, -95.67780