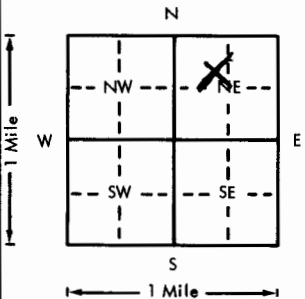


USE TYPEWRITER OR BALL POINT PEN—PRESS FIRMLY, PRINT CLEARLY.

WATER WELL RECORD  
KSA 82a-1201-1215

Kansas Department of Health and Environment—Division of Environment  
(Water well Contractors)  
Topeka, Kansas 66620

1. Location of well: County <u>Shawnee</u> Fraction <u>SE 1/4 NW 1/4 NE 1/4</u> Section number <u>9</u> Township number <u>T 11 S R 16</u> Range number <u>EW</u>	
2. Distance and direction from nearest town or city: <u>ADD</u>	
3. Owner of well: <u>Broxterman, Marion</u> R.R. or street: <u>3750 Meriden Road</u> City, state, zip code: <u>Topeka, Kansas 66617</u>	
4. Locate with "X" in section below: Sketch map: 	
4. Bore hole dia. <u>10</u> in. Completion date <u>5/20/76</u> Well depth <u>50</u> ft.	
7. <input checked="" type="checkbox"/> Cable tool <input type="checkbox"/> Rotary <input type="checkbox"/> Driven <input type="checkbox"/> Dug <input type="checkbox"/> Hollow rod <input type="checkbox"/> Jetted <input type="checkbox"/> Bored <input type="checkbox"/> Reverse rotary	
8. Use: <input checked="" type="checkbox"/> Domestic <input type="checkbox"/> Public supply <input type="checkbox"/> Industry <input type="checkbox"/> Irrigation <input type="checkbox"/> Air conditioning <input type="checkbox"/> Stock <input type="checkbox"/> Lawn <input type="checkbox"/> Oil field water <input type="checkbox"/> Other	
9. Casing: Material <u>PVC</u> Height: Above or below Threaded <input type="checkbox"/> Welded <input type="checkbox"/> Surface <u>36</u> in. RMP <input type="checkbox"/> PVC <input checked="" type="checkbox"/> Weight <u>200</u> lbs./ft. Dia. <u>2</u> in. to <u>4</u> ft. depth; Wall Thickness: inches or Dia. <u>1/2</u> in. to <u>1</u> ft. depth; gage No. <u>1</u>	
10. Screen: Manufacturer's name <u>Modern Pipe</u> Type <u>PVC</u> Dia. <u>5"</u> Slot/gauze <u>1/8"</u> Length <u>24'</u> Set between <u>30</u> ft. and <u>50</u> ft. <u>22</u> ft. and <u>26</u> ft. Gravel pack? <input checked="" type="checkbox"/> Yes Size range of material <u>1/2"</u>	
5. Type and color of material	
	From To
<u>Top Soil</u>	0 3
<u>Brown Clay</u>	3 12
<u>Yellow Clay with Sand and Graval</u>	12 20
<u>Gray Shale</u>	20 27
<u>Blue Shale</u>	27 36
<u>Blue Lime</u>	36 37
<u>Black Shale</u>	37 40
<u>Lime Rock</u>	40 47
<u>Gray Shale</u>	47 50
11. Static water level: <u>4</u> ft. below land surface Date <u>5/20/76</u> mo./day/yr.	
12. Pumping level below land surfaces: <u>    </u> ft. after <u>    </u> hrs. pumping <u>    </u> g.p.m. <u>    </u> ft. after <u>    </u> hrs. pumping <u>    </u> g.p.m. Estimated maximum yield <u>2</u> g.p.m.	
13. Water sample submitted: <u>    </u> mo./day/yr. <input type="checkbox"/> Yes <input checked="" type="checkbox"/> No Date <u>    </u>	
14. Well head completion: <input checked="" type="checkbox"/> Pitless adapter <u>36</u> Inches above grade	
15. Well grouted? <input checked="" type="checkbox"/> <u>    </u> With: <input checked="" type="checkbox"/> Neat cement <input type="checkbox"/> Bentonite <input type="checkbox"/> Concrete Depth: From <u>3</u> ft. to <u>13</u> ft.	
16. Nearest source of possible contamination: ft. <u>25</u> Direction <u>East</u> Type <u>Ditch</u> Well disinfected upon completion? <input checked="" type="checkbox"/> Yes <input type="checkbox"/> No	
17. Pump: <u>    </u> Not installed Manufacturer's name <u>Pumpco</u> Model number <u>1-2S36HP 1/3</u> Volts <u>230</u> Length of drop pipe <u>44</u> ft. capacity <u>7</u> g.p.m. Type: <input checked="" type="checkbox"/> Submersible <input type="checkbox"/> Turbine <input type="checkbox"/> Jet <input type="checkbox"/> Reciprocating <input type="checkbox"/> Centrifugal <input type="checkbox"/> Other	
(Use a second sheet if needed)	
18. Elevation: <u>~985</u> Topography: <u>Rm</u> <input checked="" type="checkbox"/> Hill <input type="checkbox"/> Slope <input type="checkbox"/> Upland <input type="checkbox"/> Valley	19. Remarks: <u>Slab to be installed by customer. He knows this is a regulation.</u>
20. Water well contractor's certification: This well was drilled under my jurisdiction and this report is true to the best of my knowledge and belief. <u>Cummings Drilling Co. 148</u> Business name <u>    </u> License No. <u>    </u> Address <u>    </u> Signed <u>    </u> Date <u>8/3/76</u> Authorized representative	

11 16 9-SE 1/4 NE 1/4