511

GRAM

check el

USE TYPEWRITER OR BALL POINT PEN-PRESS FIRMLY, PRINT CLEARLY.

WATER WELL RECORD
KSA 82a-1201-1215

.8

CCD

Kansas Department of Health and Environment-Division of Environment
(Water well Contractors)
Topeka, Kansas 66620

| 1. Location of well: | County | Fraction | Section number | Township number | Range number |
|---|---|---|---|---|---|
| | Shawnee | SE 1/4 ~~SE~~ 1/4 SW 1/4 (SW) | 11 | T 11 S | R 16 E W |

2. Distance and direction from nearest town or city:

Street address of well location if in city:

3. Owner of well: Flatten, J. W.
R.R. or street: 2120 N.E. ~~37th~~ N.E. 31st
City, state, zip code: Topeka, Kansas 66617

4. Locate with "X" in section below:

Sketch map:

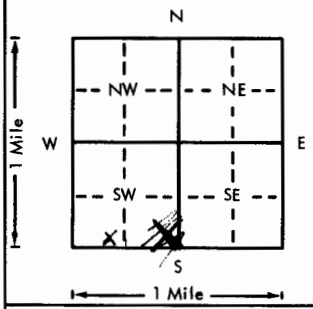


6. Bore hole dia. 10 in. Completion date 7/24/76
Well depth 40 ft.

7. X Cable tool __ Rotary __ Driven __ Dug
__ Hollow rod __ Jetted __ Bored __ Reverse rotary

8. Use: X Domestic __ Public supply __ Industry
__ Irrigation __ Air conditioning __ Stock
__ Lawn __ Oil field water __ Other

9. Casing: Material PVC Height: Above or below
Threaded ___ Welded ___ Surface 36 in.
RMP ___ PVC X Weight Sch. 40 /ft.
Dia. X in. to X ft. depth Wall Thickness: inches or
Dia. ___ in. to ___ ft. depth Gage No. ___

| 5. Type and color of material | From | To |
|---|---|---|
| Top Soil | 0 | 4 |
| Brown Clay with Fine Sand | 4 | 16 |
| Gravel in Brown Clay | 16 | 23 |
| Gray Shale | 23 | 36 |
| White Lime | 36 | 40 |

(Use a second sheet if needed)

10. Screen: Manufacturer's name Modern Pipe
Type PVC Dia. 5"
Slot/gauze 1 Length 23'
Set between 18 ft. and 40 ft.
___ ft. and ___ ft.
Gravel pack? Yes Size range of material 3

11. Static water level: mo./day/yr.
10 ft. below land surface Date 7/24/76

12. Pumping level below land surfaces:
___ ft. after ___ hrs. pumping ___ g.p.m.
___ ft. after ___ hrs. pumping ___ g.p.m.
Estimated maximum yield 12 g.p.m.

13. Water sample submitted: mo./day/yr.
__ Yes X No Date ___

14. Well head completion:
X Pitless adapter 36" Inches above grade

15. Well grouted? Yes
With: X Neat cement ___ Bentonite ___ Concrete
Depth: From 3 ft. to 13 ft.

16. Nearest source of possible contamination:
ft. 15 Direction West Type Stream
Well disinfected upon completion? X Yes ___ No

17. Pump: ___ Not installed
Manufacturer's name Pumpco
Model number 102S36 HP 1/3 Volts 230
Length of drop pipe ___ ft. capacity 10 g.p.m.
Type:
X Submersible ___ Turbine
___ Jet ___ Reciprocating
___ Centrifugal ___ Other

T 11 R 16 E W Sec 11 1/4 SE SE SW

18. Elevation: 919 Rm
Topography:
___ Hill
___ Slope
X Upland
___ Valley

19. Remarks:

20. Water well contractor's certification:
This well was drilled under my jurisdiction and this report is true to the best of my knowledge and belief.
Cummings Drilling Co. 148
Business name License No.
Rt 10 Topeka KS
Address
Signed Jeanette Cummings Date 8/3/76
Authorized representative

Forward the white, blue and pink copies to the Department of Health and Environment

Form WWC-5