


1 LOCATION OF WATER WELL: Fraction SE 1/4 SW 1/4 SE 1/4 Section Number 14 Township Number T 11 S Range Number R 16 EW

Distance and direction from nearest town or city street address of well if located within city: 2620 N.E. Grantville Rd. Topeka, Kansas 66617

2 WATER WELL OWNER: Bourne's Trailer Ct. Riv. Valley RR#, St. Address, Box #: 2620 N.E. Grantville, Rd City, State, ZIP Code: Topeka, Kansas 66617 Board of Agriculture, Division of Water Resources Application Number:

3 LOCATE WELL'S LOCATION WITH AN "X" IN SECTION BOX:

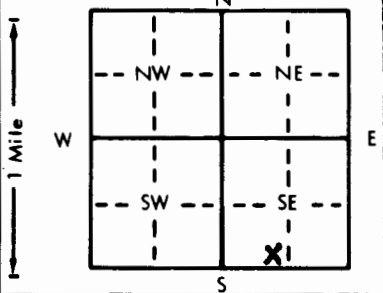

4 DEPTH OF COMPLETED WELL: 52 ft. ELEVATION:

Depth(s) Groundwater Encountered 1. 39 ft. 2. ft. 3. ft. WELL'S STATIC WATER LEVEL 25 ft. below land surface measured on mo/day/yr 6-21-82 Pump test data: Well water was 46 ft. after 1 hours pumping 30 gpm Est. Yield 30 gpm: Well water was ft. after hours pumping gpm Bore Hole Diameter 15 in. to 52 ft., and in. to ft. WELL WATER TO BE USED AS: 5 Public water supply 8 Air conditioning 11 Injection well 1 Domestic 3 Feedlot 6 Oil field water supply 9 Dewatering 12 Other (Specify below) 2 Irrigation 4 Industrial 7 Lawn and garden only 10 Observation well Was a chemical/bacteriological sample submitted to Department? Yes X No; If yes, mo/day/yr sample was submitted 6-22-82 Water Well Disinfected? Yes No

5 TYPE OF BLANK CASING USED: 1 Steel 2 PVC 3 RMP (SR) 4 ABS 5 Wrought iron 6 Asbestos-Cement 7 Fiberglass 8 Concrete tile 9 Other (specify below) CASING JOINTS: Glued Clamped Welded Threaded

Blank casing diameter 6 in. to 46 ft., Dia in. to ft., Dia in. to ft. Casing height above land surface 24 in., weight 3.58 lbs./ft. Wall thickness or gauge No. 280

TYPE OF SCREEN OR PERFORATION MATERIAL: 1 Steel 2 Brass 3 Stainless steel 4 Galvanized steel 5 Fiberglass 6 Concrete tile 7 PVC 8 RMP (SR) 9 ABS 10 Asbestos-cement 11 Other (specify) 12 None used (open hole)

SCREEN OR PERFORATION OPENINGS ARE: 1 Continuous slot 2 Louvered shutter 3 Mill slot 4 Key punched 5 Gauzed wrapped 6 Wire wrapped 7 Torch cut 8 Saw cut 9 Drilled holes 10 Other (specify) Johnson 11 None (open hole)

SCREEN-PERFORATED INTERVALS: From 46 ft. to 52 ft., From ft. to ft. GRAVEL PACK INTERVALS: From 27 ft. to 52 ft., From ft. to ft.

6 GROUT MATERIAL: 1 Neat cement 2 Cement grout 3 Bentonite 4 Other Grout intervals: From 6 ft. to 27 ft., From ft. to ft.

What is the nearest source of possible contamination: 1 Septic tank 2 Sewer lines 3 Watertight sewer lines 4 Lateral lines 5 Cess pool 6 Seepage pit 7 Pit privy 8 Sewage lagoon 9 Feedyard 10 Livestock pens 11 Fuel storage 12 Fertilizer storage 13 Insecticide storage 14 Abandoned water well 15 Oil well/Gas well 16 Other (specify below)

Direction from well? WEST How many feet? 75

Table with columns: FROM, TO, LITHOLOGIC LOG, FROM, TO, LITHOLOGIC LOG. Data rows: 0-7 Top Soil, 7-39 Tan silt flour sand, 39-52 yell f-c sand.

7 CONTRACTOR'S OR LANDOWNER'S CERTIFICATION: This water well was (1) constructed, (2) reconstructed, or (3) plugged under my jurisdiction and was completed on (mo/day/year) 6-21-82 and this record is true to the best of my knowledge and belief. Kansas Water Well Contractor's License No. 182 This Water Well Record was completed on (mo/day/yr) 7-1-82 under the business name of Strader Drilling Co., Inc. by (signature) Dale Ashen

INSTRUCTIONS: Use typewriter or ball point pen, PLEASE PRESS FIRMLY and PRINT clearly. Please fill in blanks, underline or circle the correct answers. Send top three copies to Kansas Department of Health and Environment, Division of Environment, Environmental Geology Section, Topeka, KS 66620. Send one to WATER WELL OWNER.

OFFICE USE ONLY T 11 R 16 EW SEC. 14 SE 1/4 SW 1/4 SE 1/4